

**M Metro**

APPROVED

APPROVED AS NOTED  
(no resubmittal required)

REJECTED, REVISE & RESUBMIT

FOR RECORD ONLY

Director, Construction MGR/ Engineer: *[Signature]* Date: *10/10/14*




**SITE PLAN**

1" = 40'-0"

1

A-3001

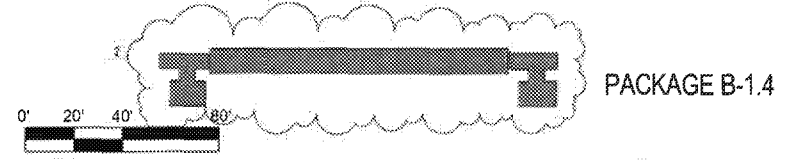

THE PREPARATION OF THIS DRAWING HAS BEEN FINANCED IN PART THROUGH A GRANT FROM THE U.S. DEPARTMENT OF TRANSPORTATION, FEDERAL TRANSIT ADMINISTRATION (FTA), UNDER THE FEDERAL TRANSIT ACT OF 1964, AS AMENDED, AND IN PART BY THE TAXES OF THE CITIZENS OF LOS ANGELES COUNTY AND OF THE STATE OF CALIFORNIA.										DESIGNED BY E. SANCHEZ DRAWN BY R. RESURRECCION CHECKED BY S. SOGHOMONIAN IN CHARGE E. SANCHEZ DATE 5/21/15										A SIGNED & SEALED ORIGINAL OF REV 0 OF THIS DRAWING IS MAINTAINED BY WSCC										<b>M Metro</b> LOS ANGELES COUNTY METROPOLITAN TRANSPORTATION AUTHORITY WALSH-SHEA CORRIDOR CONSTRUCTORS 1777 Oakland Blvd. Walnut Creek, CA 94596										<b>HNTB</b> STEVE WHITAKER APPROVED										<b>MTHM</b> EFRAIN SANCHEZ SUBMITTED										CONTRACT NO. C0988 SHEET NO. A-3001 SCALE 1" = 40'-0" REV 2									
REV	DATE	BY	APP	REG NO	EXPIRES	SEAL HOLDER	DESCRIPTION	REV	DATE	BY	APP	REG NO	EXPIRES	SEAL HOLDER	DESCRIPTION	REV	DATE	BY	APP	REG NO	EXPIRES	SEAL HOLDER	DESCRIPTION																																														
0	10/21/15	ES	ES	C25553	03/31/17	E. SANCHEZ	NDC 065	1	11/30/17	R. RESURRECCION	ES	C34273	11/30/17	E. SANCHEZ	NDC 081	2	10/21/15	ES	ES	C25553	03/31/17	E. SANCHEZ	AFC SUBMITTAL																																														