



FLOOR MOUNTED ROUND ASH RECEPTACLE SEE 1/AS-019

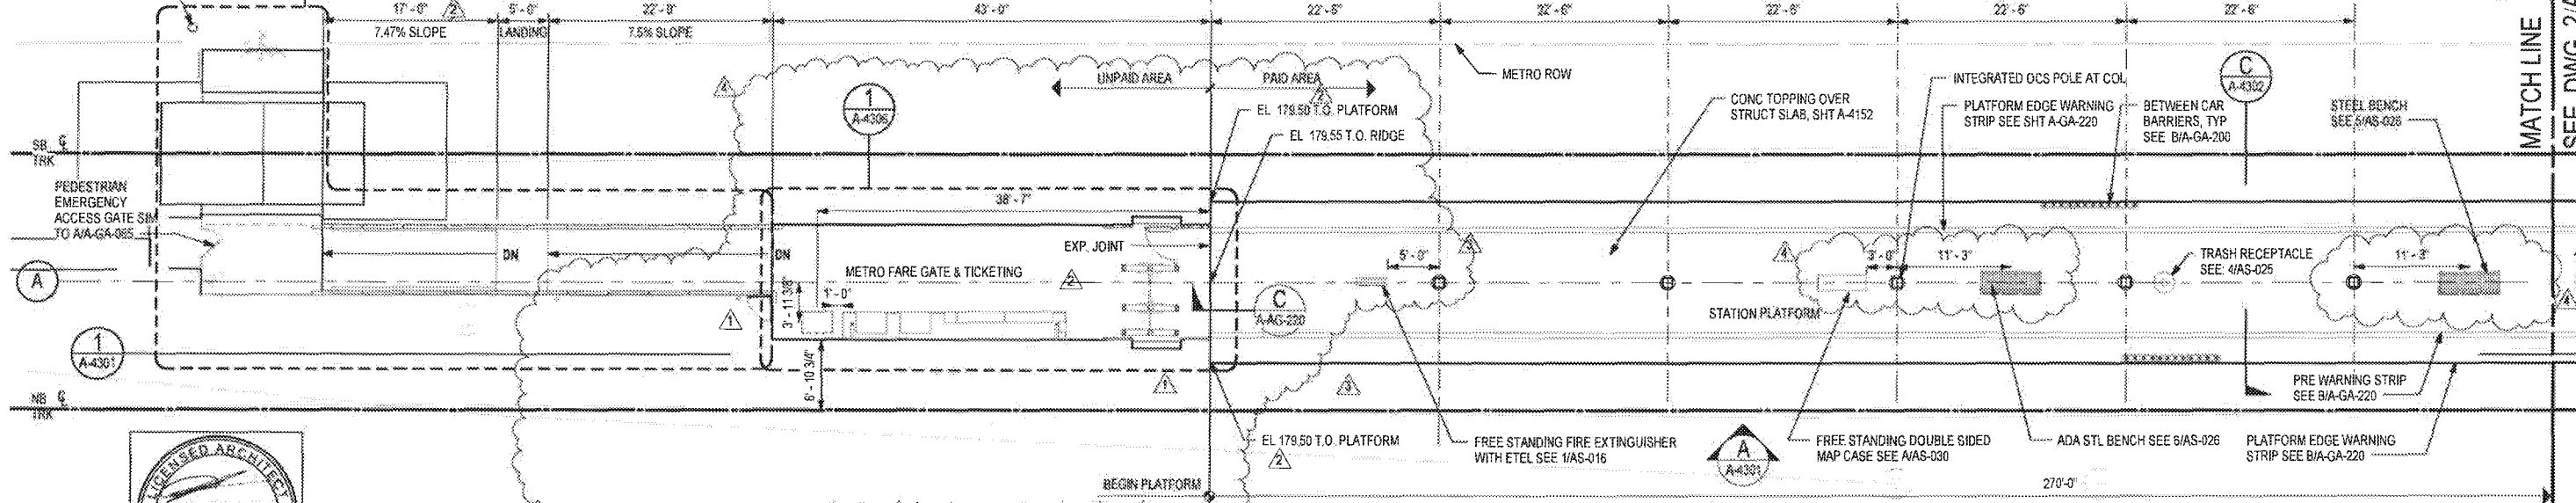

PARTIAL PLATFORM PLAN

1/8" = 1'-0"

1 A-4111 A-4001

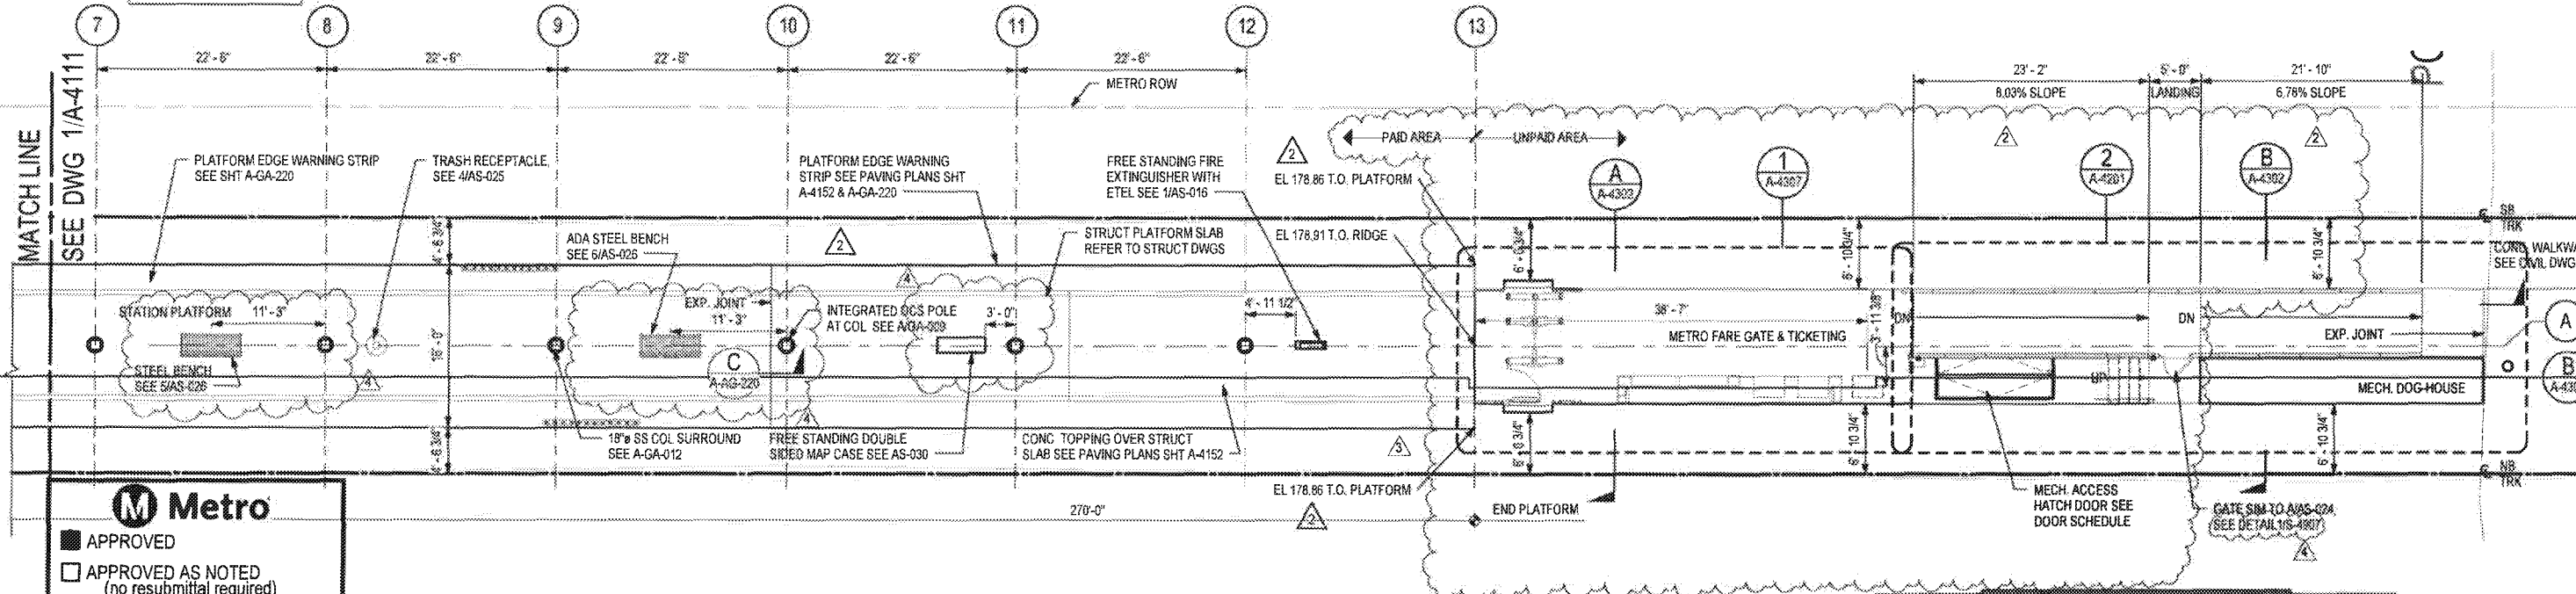

PARTIAL PLATFORM PLAN

1/8" = 1'-0"


2 A-4111 A-4001

Metro

APPROVED
 APPROVED AS NOTED (no resubmittal required)
 REJECTED, REVISE & RESUBMIT
 FOR RECORD ONLY

Director, Construction MGMT Engineer

Marta Diaz 5/24/17

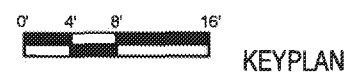

REV	DATE	BY	APP	REG NO	EXPIRES	SEAL HOLDER	DESCRIPTION
0	5/21/15			C25553	3/31/17	E. SANCHEZ	AFC SUBMITTAL
1	10/21/15	E.S.	E.S.	C25553	3/31/17	E. SANCHEZ	NDC 065
2	2/12/16	E.S.	E.S.	C25553	3/31/17	E. SANCHEZ	NDC 085
3	4/29/16	AH	RP	C34273	11/30/17	R. PAPOCCHIA	NDC 086
4	6/16/17	SL	PT	C21914	8/31/17		NDC 267, NDC 192, RFI 836, A, RFI 1036

DESIGNED BY: E. SANCHEZ

DRAWN BY: R. RESURRECCION

CHECKED BY: S. SOGHOMONIAN

IN CHARGE: E. SANCHEZ

DATE: 5/21/15

A SIGNED & SEALED ORIGINAL OF REV 0 OF THIS DRAWING IS MAINTAINED BY WSCC

Metro LOS ANGELES COUNTY METROPOLITAN TRANSPORTATION AUTHORITY

1777 Oakland Blvd, Walnut Creek, CA 94596

HNTB STEVE WHITAKER APPROVED

MM EFRAN SANCHEZ 808467136

CONTRACT NO: C0988

DRAWING NO: A-4111

SCALE: 1/8" = 1'-0"

SHEET NO:

REV 4


6/2/2017 5:25:04 PM

C:\Users\mtrung\Documents\C0988\A-4111.dwg

M Metro

APPROVED
 APPROVED AS NOTED
 (no resubmittal required)
 REJECTED, REVISE & RESUBMIT
 FOR RECORD ONLY

Director, Construction MGR/ Engineer: *M. Hernandez* Date: *8/24/17*

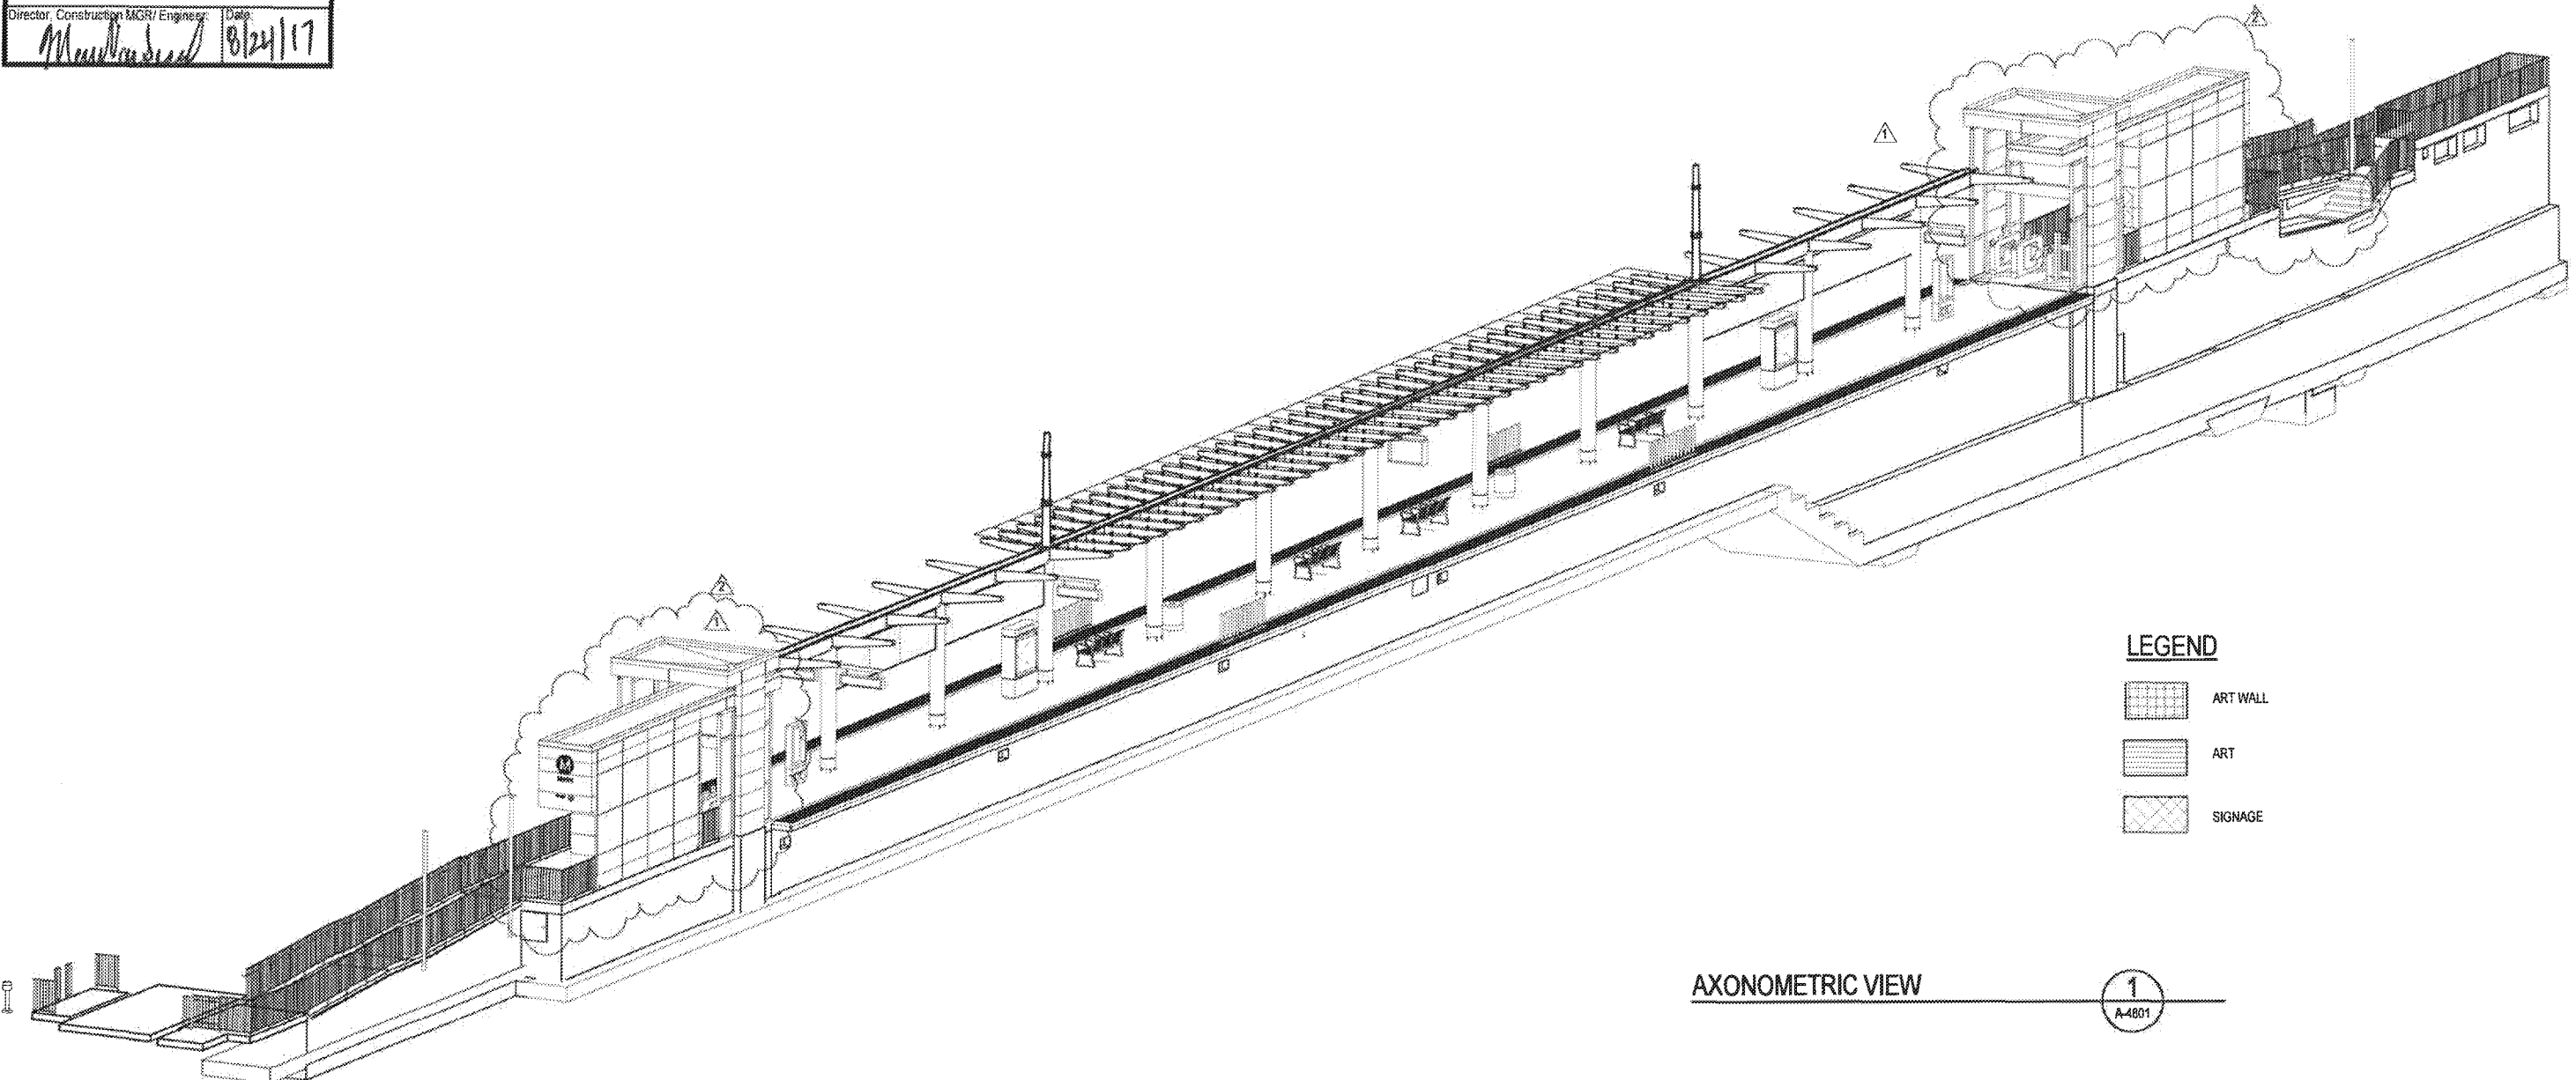

LEGEND

- ART WALL
- ART
- SIGNAGE

AXONOMETRIC VIEW

1
A-4801

LICENSED ARCHITECT
CERTIFIES
REVISION 2 ONLY

PACKAGE B-1.4

THE PREPARATION OF THIS DRAWING HAS BEEN FINANCED IN PART THROUGH A GRANT FROM THE U.S. DEPARTMENT OF TRANSPORTATION, FEDERAL TRANSIT ADMINISTRATION (FTA), UNDER THE FEDERAL TRANSIT ACT OF 1954, AS AMENDED, AND IN PART BY THE TAXES OF THE CITIZENS OF LOS ANGELES COUNTY AND OF THE STATE OF CALIFORNIA.

REV	DATE	BY	APP	REG NO	EXPIRES	SEAL HOLDER	DESCRIPTION
	6/16/17			C21914	8/31/17		NDC 257
	4/29/16	E.S.	E.S.	C34273	11/30/17	E. SANCHEZ	NDC 086
0	5/21/15			C25553	3/31/17	E. SANCHEZ	AFC SUBMITTAL

DESIGNED BY
E. SANCHEZ

DRAWN BY
R. RESURRECCION

CHECKED BY
S. SOGHOMONIAN

IN CHARGE
E. SANCHEZ

DATE
5/21/15

A SIGNED & SEALED ORIGINAL OF REV 0 OF THIS DRAWING IS MAINTAINED BY WSCC

LOS ANGELES COUNTY METROPOLITAN TRANSPORTATION AUTHORITY

Metro

WALSH-SHEA CORRIDOR CONSTRUCTORS

1777 Oakland Blvd.
Walnut Creek, CA 94596

HNTB

STEVE WHITAKER
APPROVED

JRM

EFRAIN SANCHEZ
SUBMITTED

CRENSHAW/LAX
TRANSIT CORRIDOR PROJECT
FLORENCE / WEST STATION
AXONOMETRIC VIEW - PLATFORM LEVEL

CONTRACT NO.	C0988
DRAWING NO.	A-4801
SCALE	NO SCALE
SHEET NO.	2