



FLOOR MOUNTED ROUND ASH RECEPTACLE SEE 1/AS-019

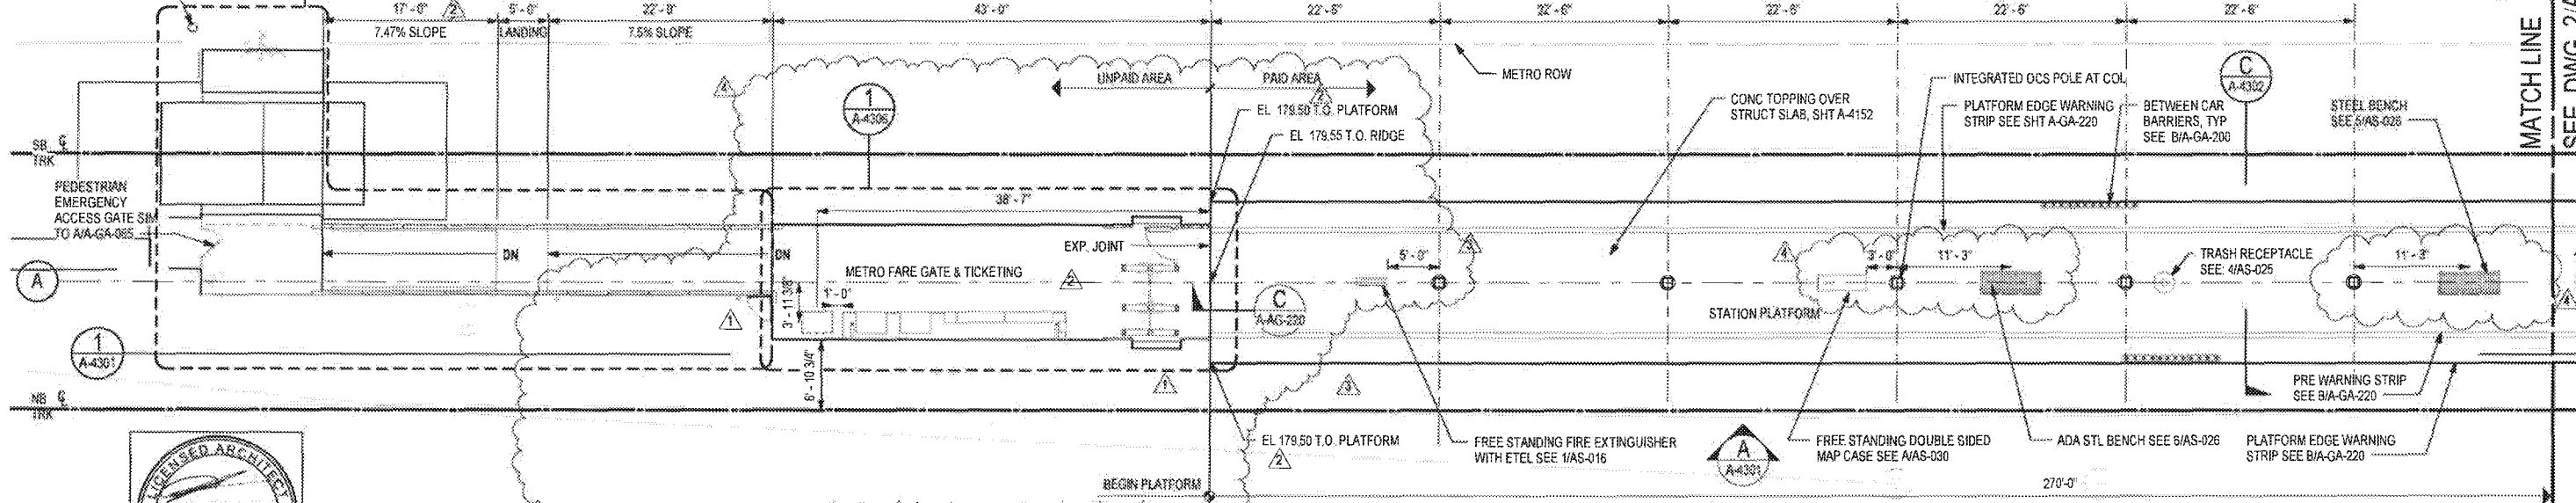

PARTIAL PLATFORM PLAN

1/8" = 1'-0"

1 A-4111 A-4001

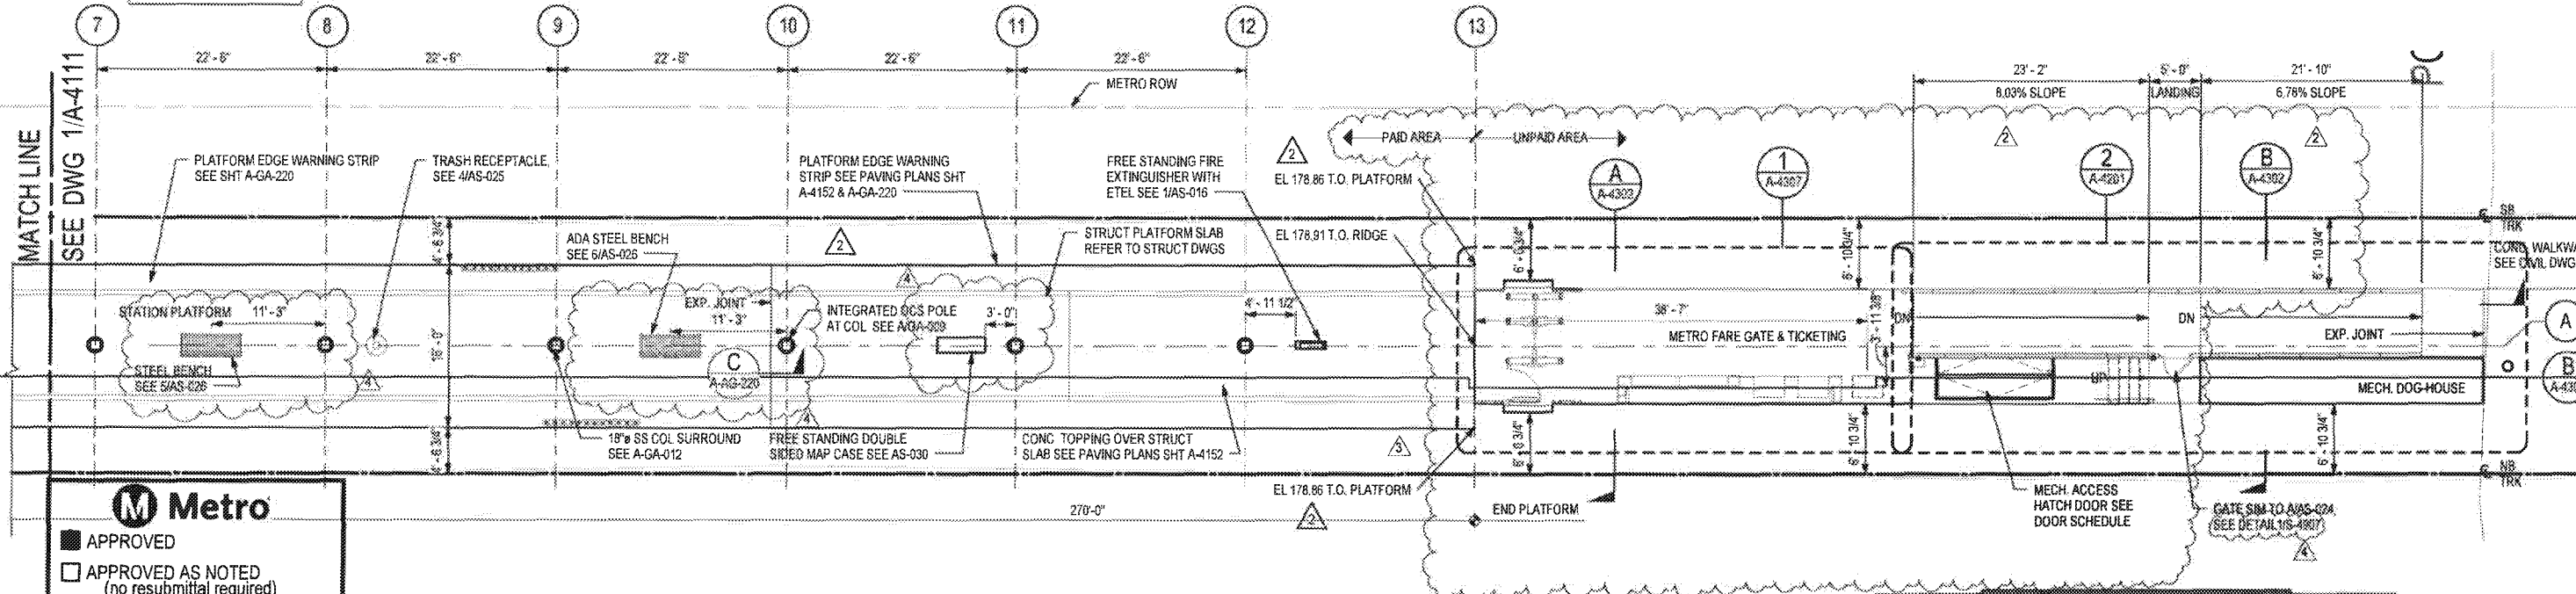

PARTIAL PLATFORM PLAN

1/8" = 1'-0"


2 A-4111 A-4001

**Metro**

APPROVED  
 APPROVED AS NOTED (no resubmittal required)  
 REJECTED, REVISE & RESUBMIT  
 FOR RECORD ONLY

Director, Construction MGR Engineer

*Marta Diaz* 5/24/17

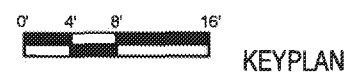

REV	DATE	BY	APP	REG NO	EXPIRES	SEAL HOLDER	DESCRIPTION
0	5/21/15			C25553	3/31/17	E. SANCHEZ	AFC SUBMITTAL
1	10/21/15	E.S.	E.S.	C25553	3/31/17	E. SANCHEZ	NDC 065
2	2/12/16	E.S.	E.S.	C25553	3/31/17	E. SANCHEZ	NDC 085
3	4/29/16	AH	RP	C34273	11/30/17	R. PAPOCCHIA	NDC 086
4	6/16/17	SL	PT	C21914	8/31/17		NDC 267, NDC 192, RFI 836, A, RFI 1036

DESIGNED BY: E. SANCHEZ

DRAWN BY: R. RESURRECCION

CHECKED BY: S. SOGHOMONIAN

IN CHARGE: E. SANCHEZ

DATE: 5/21/15

A SIGNED & SEALED ORIGINAL OF REV 0 OF THIS DRAWING IS MAINTAINED BY WSCC

**Metro** LOS ANGELES COUNTY METROPOLITAN TRANSPORTATION AUTHORITY

1777 Oakland Blvd, Walnut Creek, CA 94596

**HNTB** STEVE WHITAKER APPROVED

**MM** EFRAN SANCHEZ 808467136

CONTRACT NO: C0988

DRAWING NO: A-4111

SCALE: 1/8" = 1'-0"

SHEET NO:

REVISIONS: REV 4


6/2/2017 5:25:04 PM

C:\Users\trajung\Documents\103868\103868\_002\_a14\_mfchseing.rvt

**M Metro**

APPROVED  
 APPROVED AS NOTED  
 (no resubmittal required)  
 REJECTED, REVISE & RESUBMIT  
 FOR RECORD ONLY

Director, Construction MGR/ Engineer: *M. Hernandez* Date: *8/24/17*

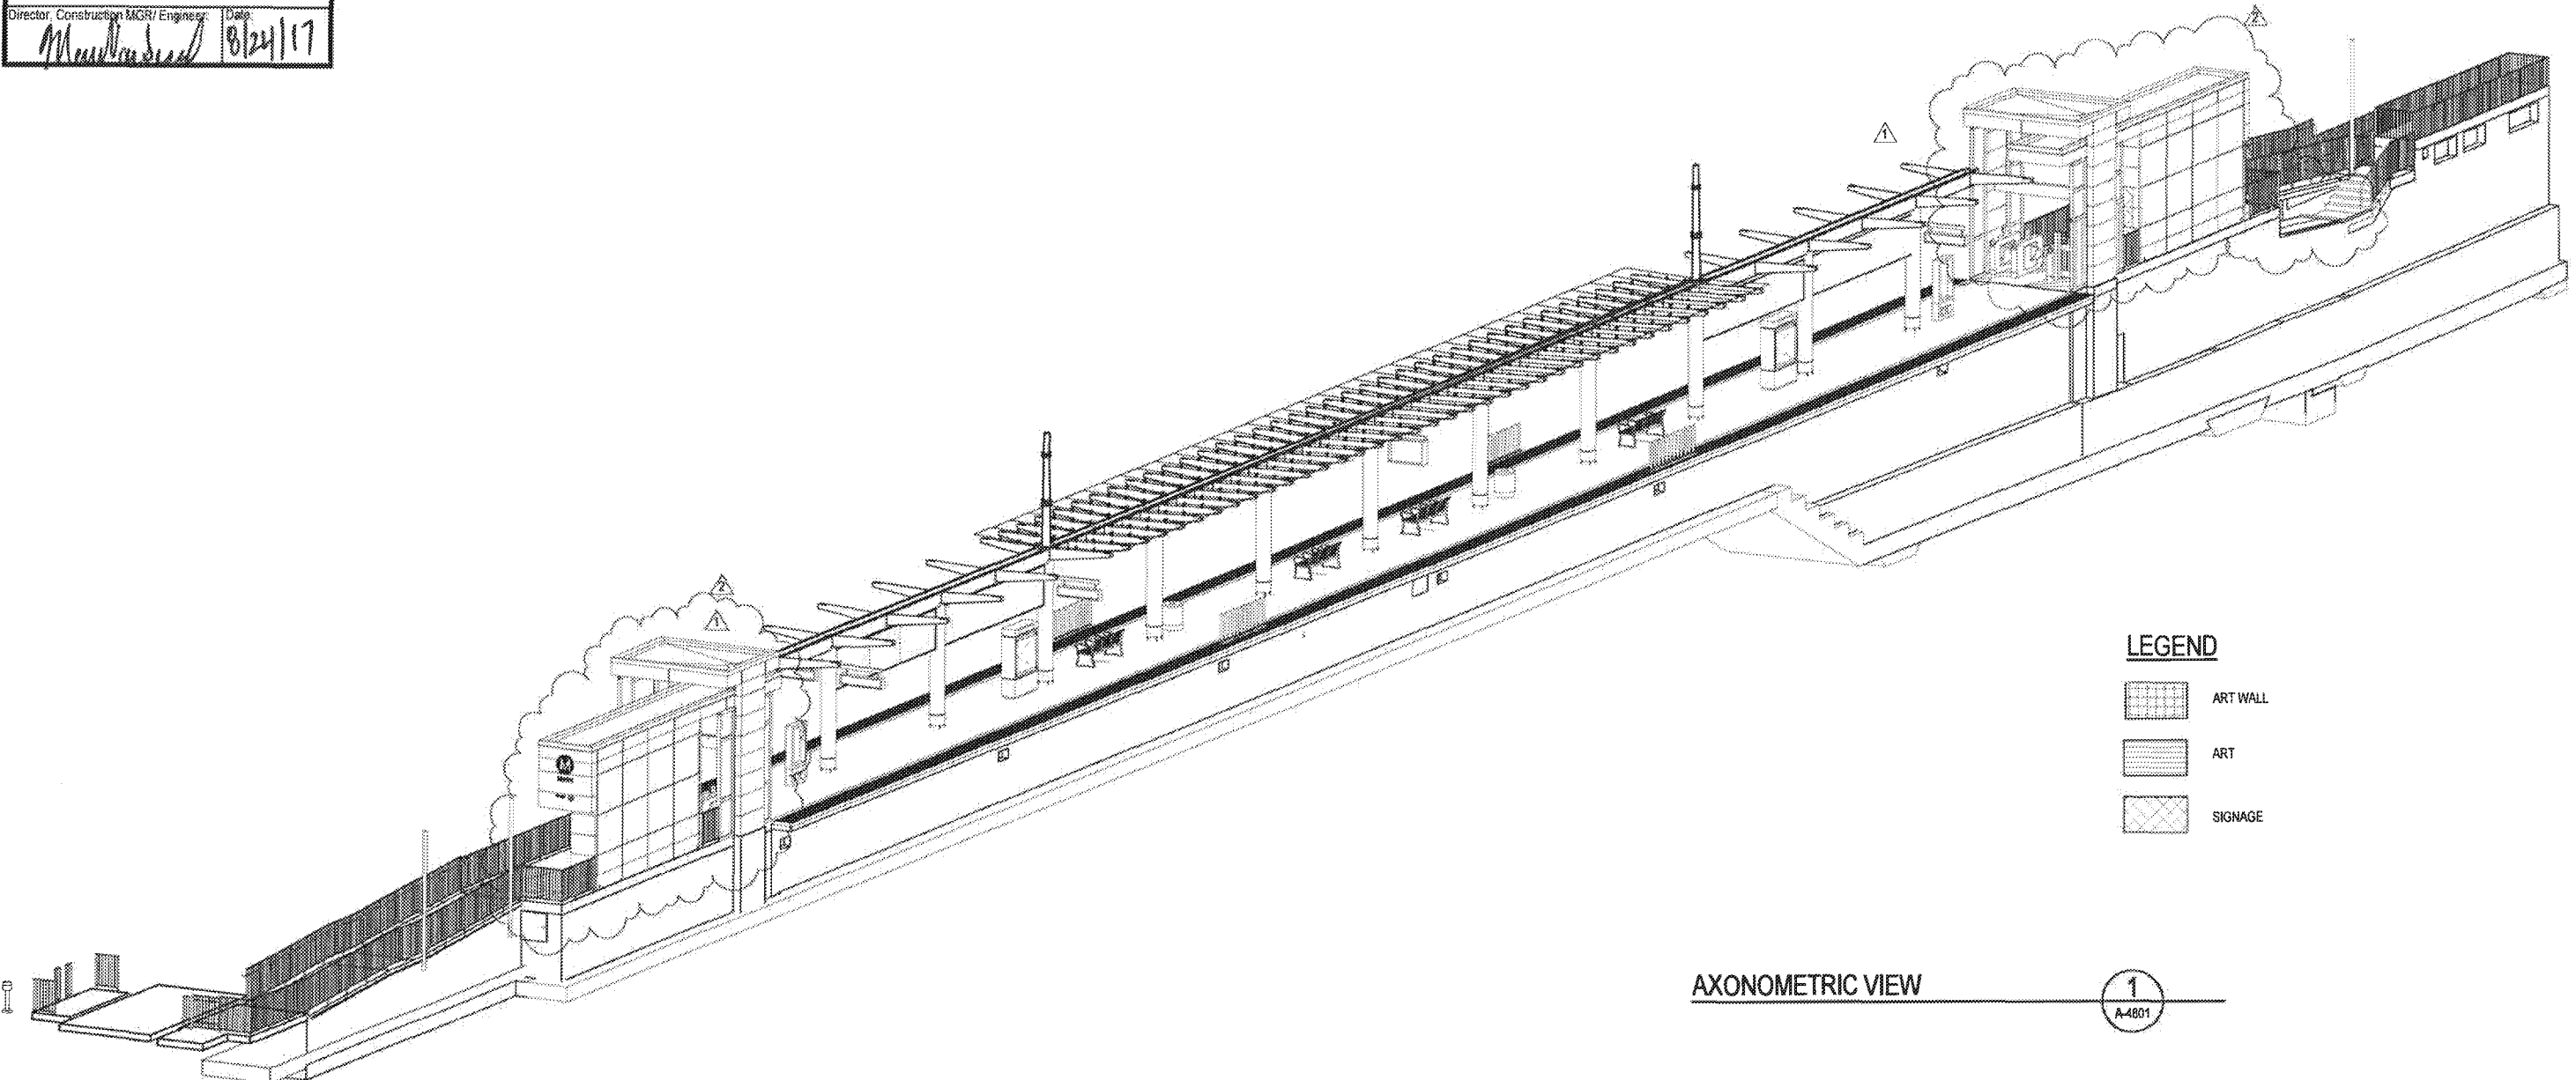

**LEGEND**

- ART WALL
- ART
- SIGNAGE

AXONOMETRIC VIEW

1  
A-4801

LICENSED ARCHITECT  
CERTIFIES  
REVISION 2 ONLY

PACKAGE B-1.4

THE PREPARATION OF THIS DRAWING HAS BEEN FINANCED IN PART THROUGH A GRANT FROM THE U.S. DEPARTMENT OF TRANSPORTATION, FEDERAL TRANSIT ADMINISTRATION (FTA), UNDER THE FEDERAL TRANSIT ACT OF 1954, AS AMENDED, AND IN PART BY THE TAXES OF THE CITIZENS OF LOS ANGELES COUNTY AND OF THE STATE OF CALIFORNIA.

REV	DATE	BY	APP	REG NO	EXPIRES	SEAL HOLDER	DESCRIPTION
	6/16/17			C21914	8/31/17		NDC 257
	4/29/16	E.S.	E.S.	C34273	11/30/17	E. SANCHEZ	NDC 086
0	5/21/15			C25553	3/31/17	E. SANCHEZ	AFC SUBMITTAL

DESIGNED BY  
E. SANCHEZ

DRAWN BY  
R. RESURRECCION

CHECKED BY  
S. SOGHOMONIAN

IN CHARGE  
E. SANCHEZ

DATE  
5/21/15

A SIGNED & SEALED ORIGINAL OF REV 0 OF THIS DRAWING IS MAINTAINED BY WSCC

LOS ANGELES COUNTY METROPOLITAN TRANSPORTATION AUTHORITY

**Metro**

WALSH-SHEA CORRIDOR CONSTRUCTORS

1777 Oakland Blvd.  
Walnut Creek, CA 94596

**HNTB**

STEVE WHITAKER  
APPROVED

**WSP**

EFRAIN SANCHEZ  
SUBMITTED

CRENSHAW/LAX  
TRANSIT CORRIDOR PROJECT  
FLORENCE / WEST STATION  
AXONOMETRIC VIEW - PLATFORM LEVEL

CONTRACT NO. C0988	REV 2
DRAWING NO. A-4801	
SCALE NO SCALE	
SHEET NO.	