

RE: IBEC Proposed draft language - GPA map amendments

Gershwin, Dan <dgershwin@coblentzlaw.com>

Mon 5/11/2020 9:03 PM

To: Mindala Wilcox <mwilcox@cityofinglewood.org>;

Cc: Royce Jones, Esq. <royce@kbblaw.com>; Loren Montgomery <loren@mcadvise.com>;

 5 attachments

General Plan Circulation Element 17 + IBECf.pdf; General Plan Circulation Element 23 +IBECf.pdf; General Plan Circulation Element 29 + IBECf.pdf; General Plan Safety Element 45a + IBECf.pdf; General Plan Safety Element 45b + IBECf.pdf;

Hi Mindy-

As discussed and requested, attached are the maps referenced in the proposed General Plan amendments submitted by Loren last week, for your consideration. Per our discussion, the Land Use Element map is not included here.

Thank you,
Dan

Dan Gershwin
Coblentz Patch Duffy & Bass LLP
415-772-5714 | Office 415-391-4800

This transmittal is intended solely for use by its addressee, and may contain confidential or legally privileged information. If you receive this transmittal in error, please email a reply to the sender and delete the transmittal and any attachments.

From: Loren Montgomery <loren@mcadvise.com>
Sent: Tuesday, May 05, 2020 2:03 PM
To: Mindala Wilcox <mwilcox@cityofinglewood.org>
Cc: Royce Jones, Esq. <royce@kbblaw.com>; Gershwin, Dan <dgershwin@coblentzlaw.com>
Subject: [EXTERNAL] Re: IBEC Proposed draft language - GPA and SPA

Hello, Mindy: See below and ignore prior email. It auto-populated with some wrong email address for you. This should work.

Thank you again and best, Loren Montgomery



From: Loren Montgomery <loren@mcadvise.com>
Date: Tuesday, May 5, 2020 at 1:54 PM
To: "Mindy Wilcox, AICP via LinkedIn" <invitations@linkedin.com>
Cc: "Royce Jones, Esq." <royce@kbblaw.com>, Dan Gershwin <dgershwin@coblentzlaw.com>
Subject: IBEC Proposed draft language - GPA and SPA

As discussed and requested, attached are proposed draft General Plan and Specific Plan amendments related to the IBEC project for your consideration.


Thanks very much.

Best, Loren Montgomery

Loren Montgomery
MONTGOMERY CLARK ADVISORS
10877 Wilshire Blvd., Ste 1102
Los Angeles, CA 90024
E-Mail: loren@mcadvise.com
Office: [\(310\) 443-7711](tel:(310)443-7711)
Mobile: [\(310\) 890-8732](tel:(310)890-8732)

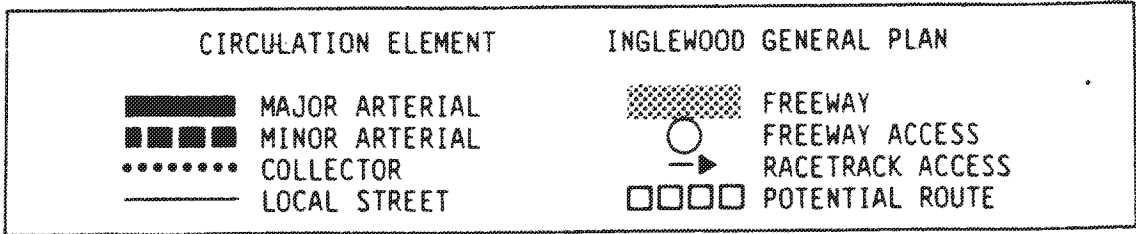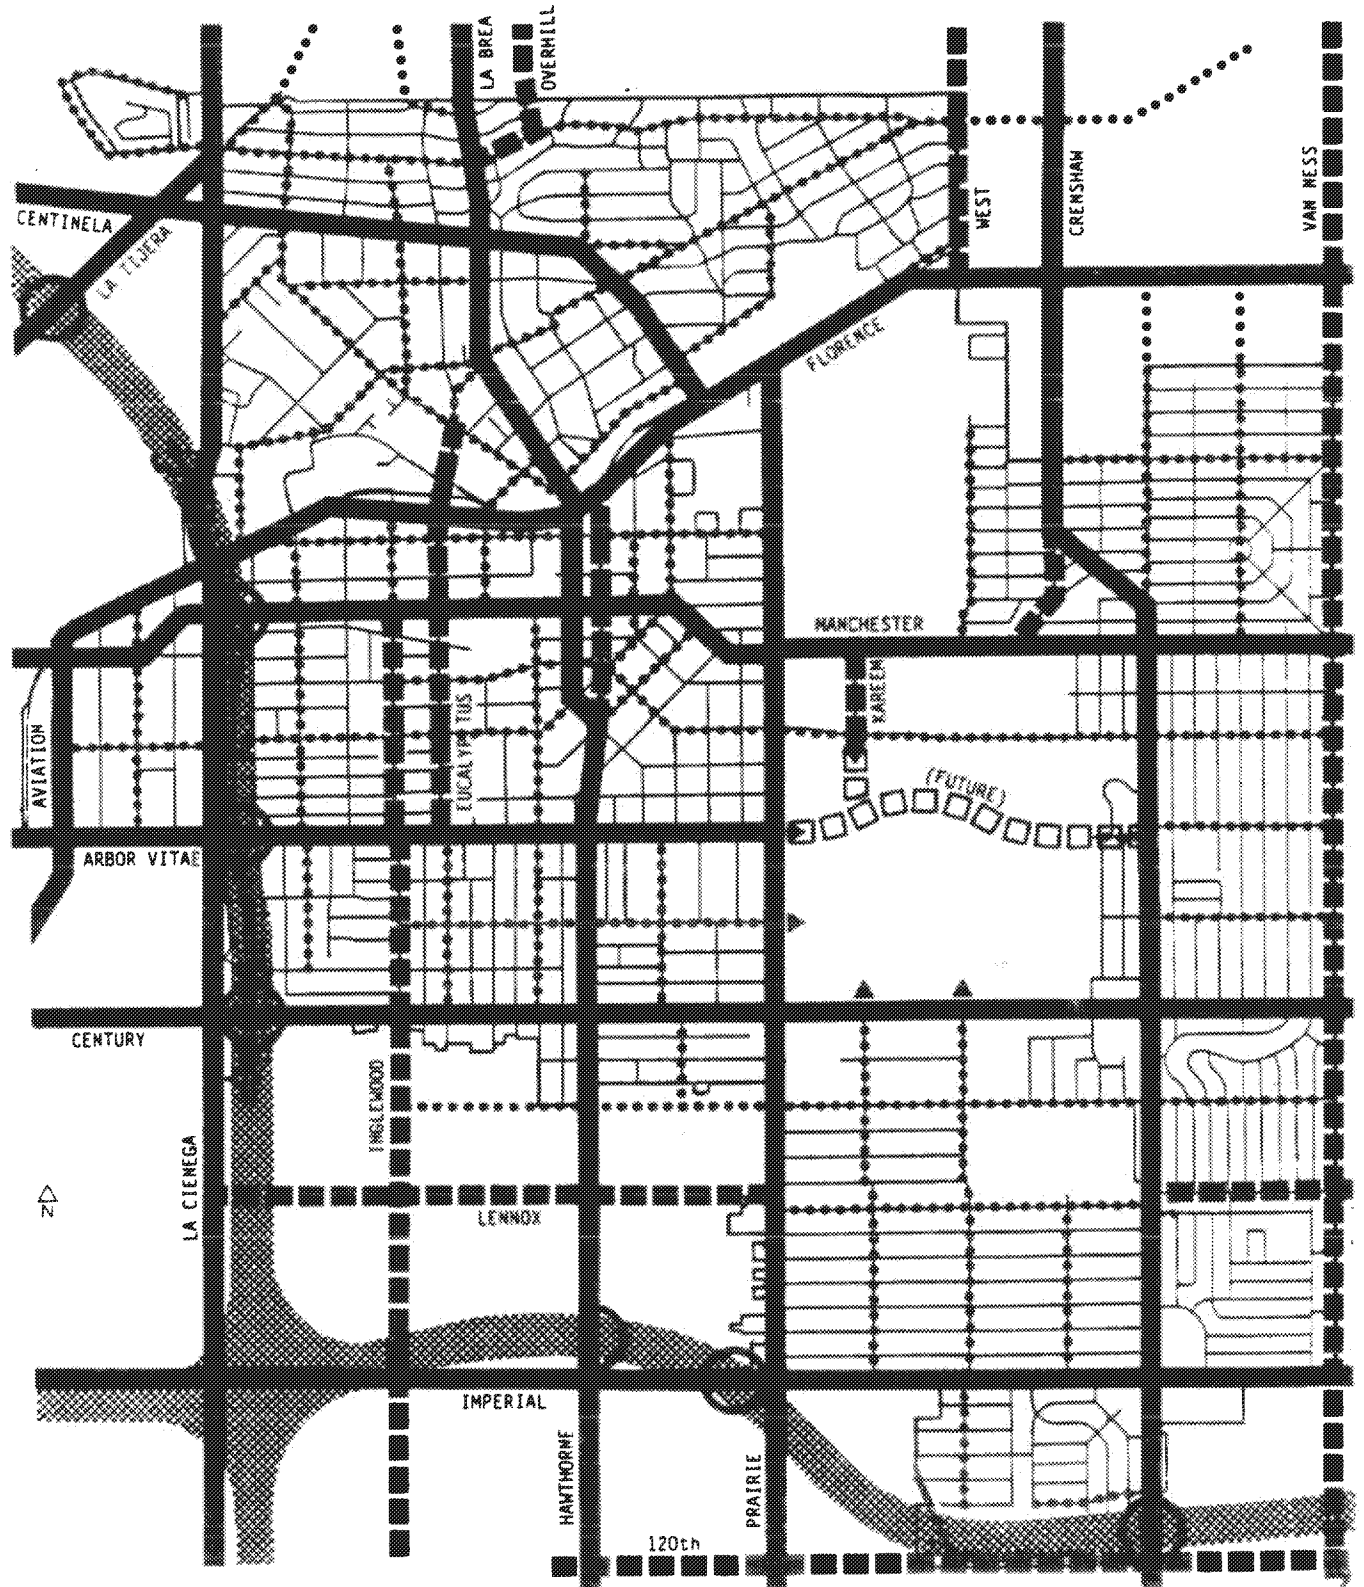



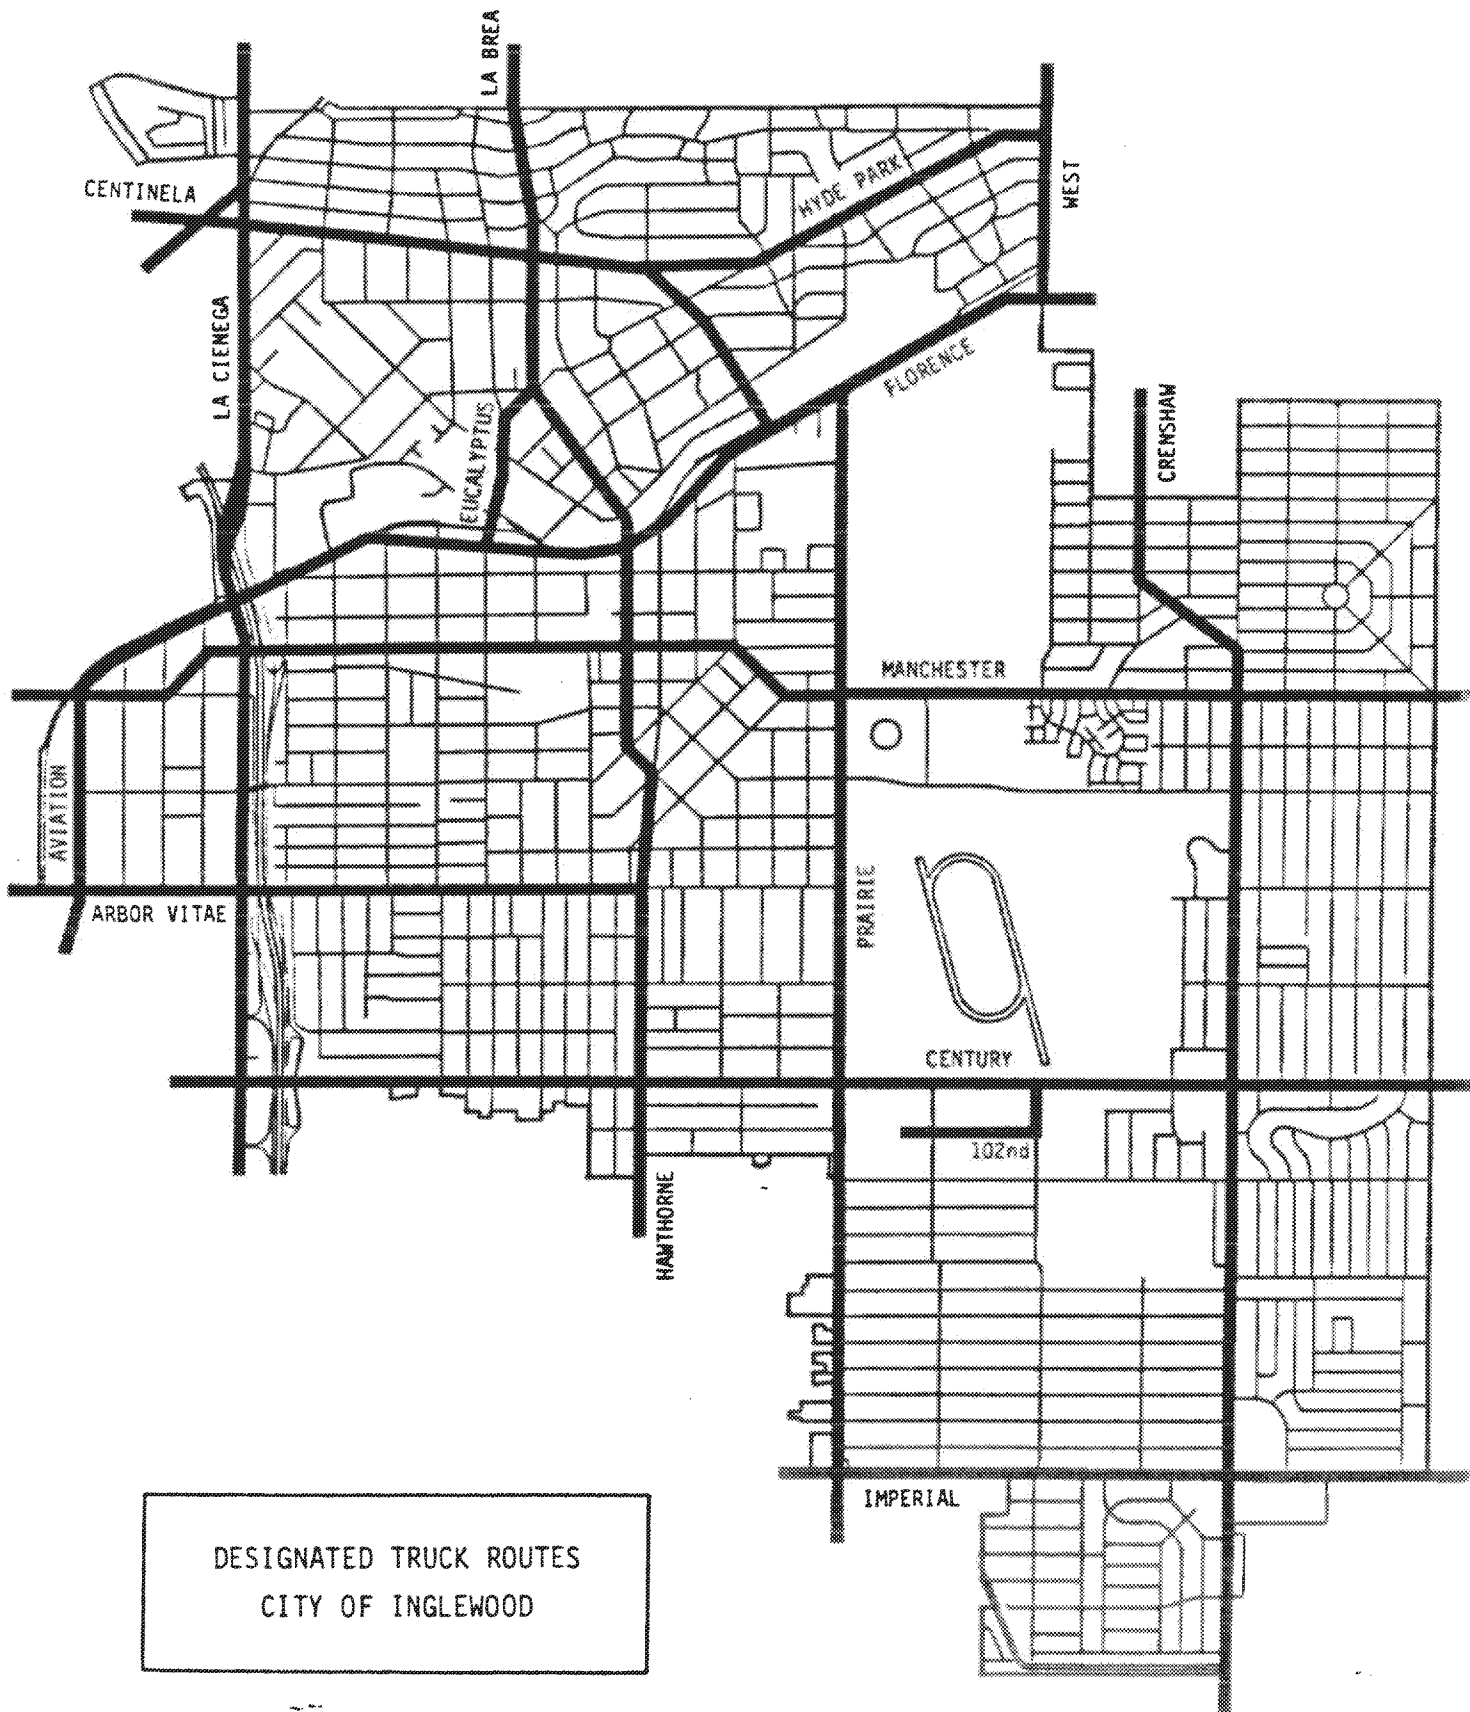

DESIGNATED TRUCK ROUTES
CITY OF INGLEWOOD


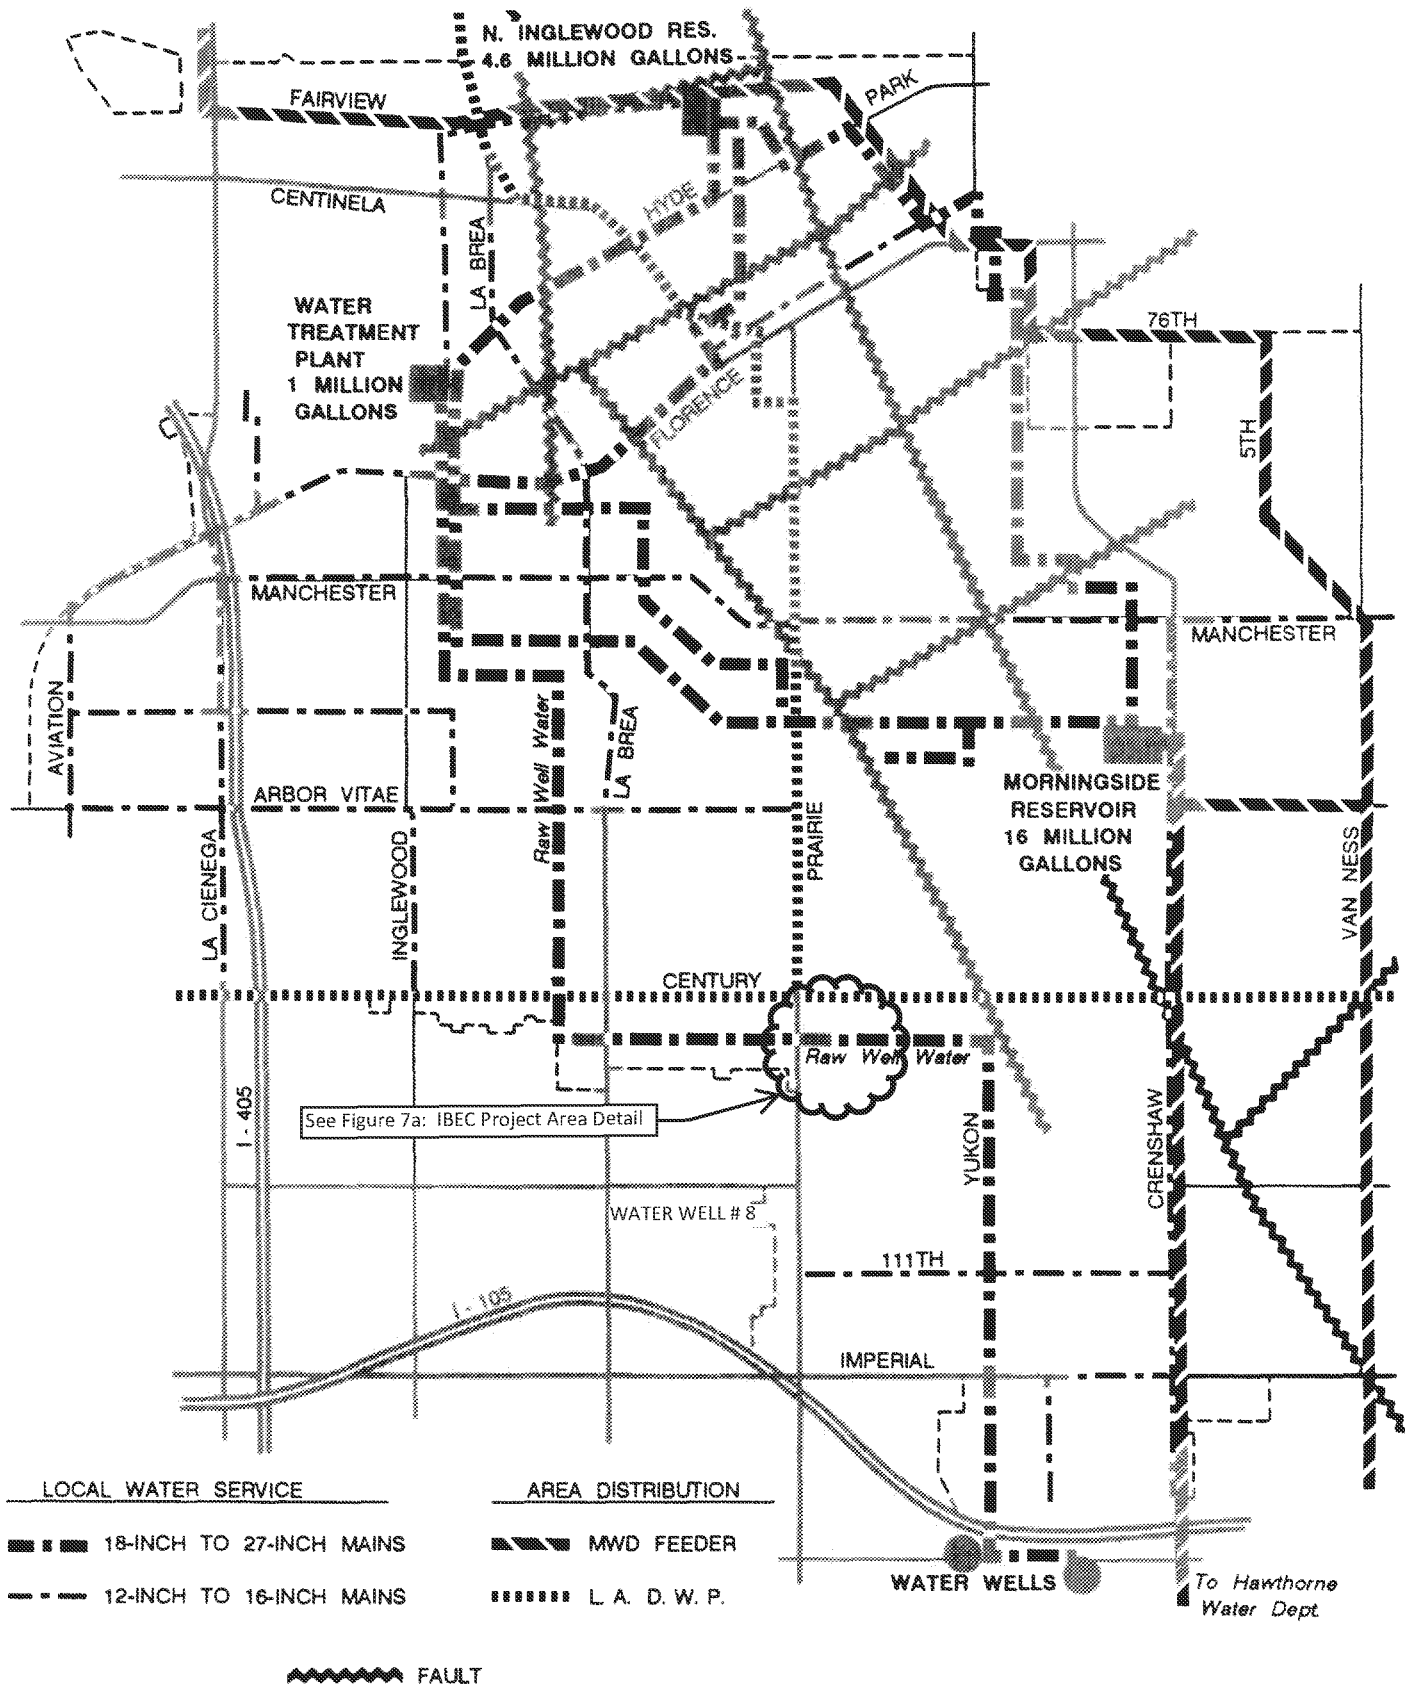


FIGURE 7. WATER DISTRIBUTION SYSTEM

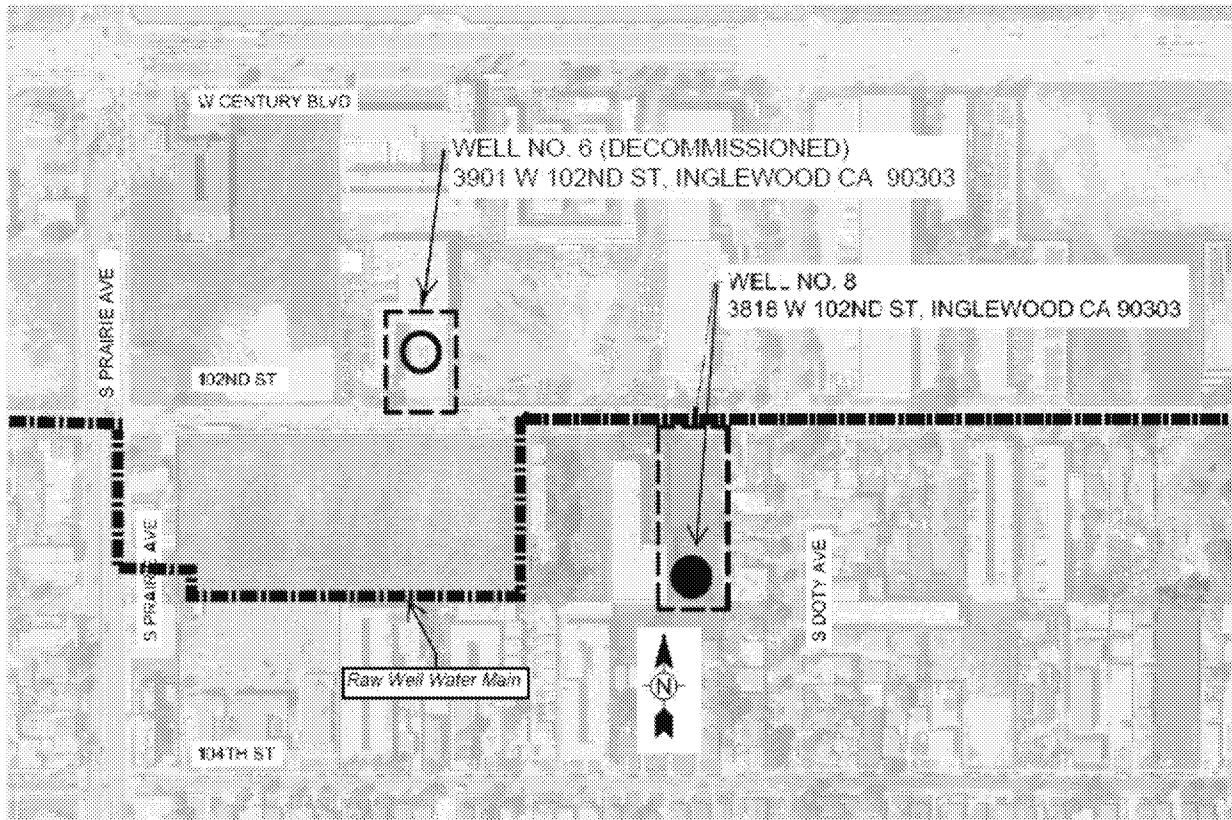

LOCAL WATER SERVICE

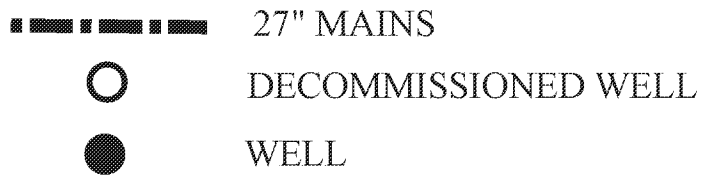


FIGURE 7a. WATER DISTRIBUTION SYSTEM – IBEC AREA DETAIL