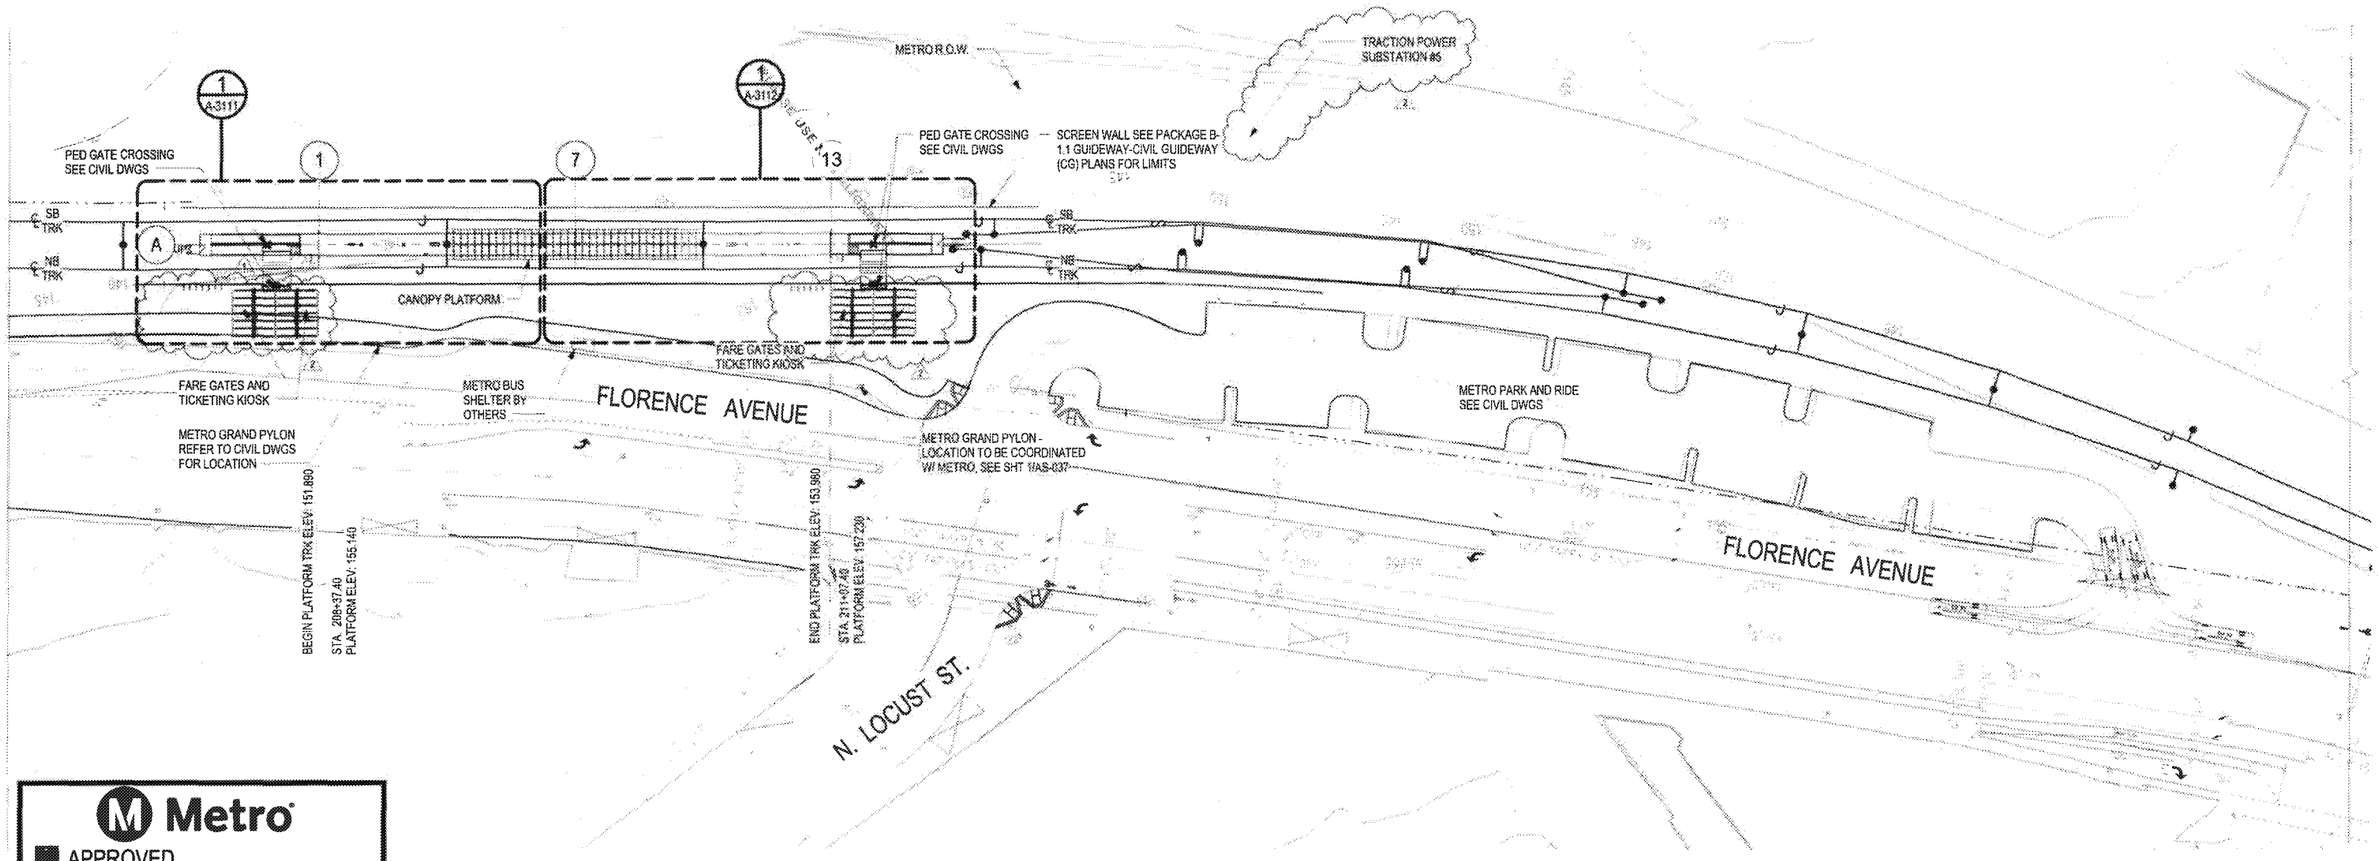


Metro

- ■ APPROVED
- ☐ APPROVED AS NOTED (no resubmittal required)
- ☐ REJECTED, REVISE & RESUBMIT
- ☐ FOR RECORD ONLY

Director, Construction MGR/ Engineer: Date: 10/10/16

REGISTERED ARCHITECT C-34273 11-30-2017 STATE OF CALIFORNIA

REGISTERED PROFESSIONAL ARCHITECT CERTIFIES REVISION 2 ONLY

## SITE PLAN

1" = 40'-0"

1 / A-3001

0' 20' 40' 80'

PACKAGE B-1.4

THE PREPARATION OF THIS DRAWING HAS BEEN FINANCED IN PART THROUGH A GRANT FROM THE U.S. DEPARTMENT OF TRANSPORTATION, FEDERAL TRANSIT ADMINISTRATION (FTA), UNDER THE FEDERAL TRANSIT ACT OF 1964, AS AMENDED, AND IN PART BY THE TAXES OF THE CITIZENS OF LOS ANGELES COUNTY AND OF THE STATE OF CALIFORNIA.

| REV | DATE | BY | APP | REG NO | EXPIRES | SEAL HOLDER | DESCRIPTION |
|---|---|---|---|---|---|---|---|
| 2 | 3/11/16 | AH | TP | C34273 | 11/30/17 | E. SANCHEZ | NDC 081 |
| 1 | 10/21/15 | ES | ES | C25553 | 03/31/17 | E. SANCHEZ | NDC 065 |
| 0 | 5/21/15 | | | C25553 | 03/31/17 | E. SANCHEZ | AFC SUBMITTAL |

DESIGNED BY E.SANCHEZ
DRAWN BY R. RESURRECCION
CHECKED BY S. SOGHOMONIAN
IN CHARGE E. SANCHEZ
DATE 5/21/15

A SIGNED & SEALED ORIGINAL OF REV 0 OF THIS DRAWING IS MAINTAINED BY WSCC

LOS ANGELES COUNTY METROPOLITAN TRANSPORTATION AUTHORITY
Metro

WALSH-SHEA CORRIDOR CONSTRUCTORS
1777 Oakland Blvd.
Walnut Creek, CA 94596

HNTB
STEVE WHITAKER
APPROVED

EFRAIN SANCHEZ
SUBMITTED

# CRENSHAW/LAX TRANSIT CORRIDOR PROJECT
## FLORENCE / LA BREA STATION
## SITE PLAN

CONTRACT NO C0988
DRAWING NO A-3001
REV 2
SCALE 1" = 40'-0"
SHEET NO