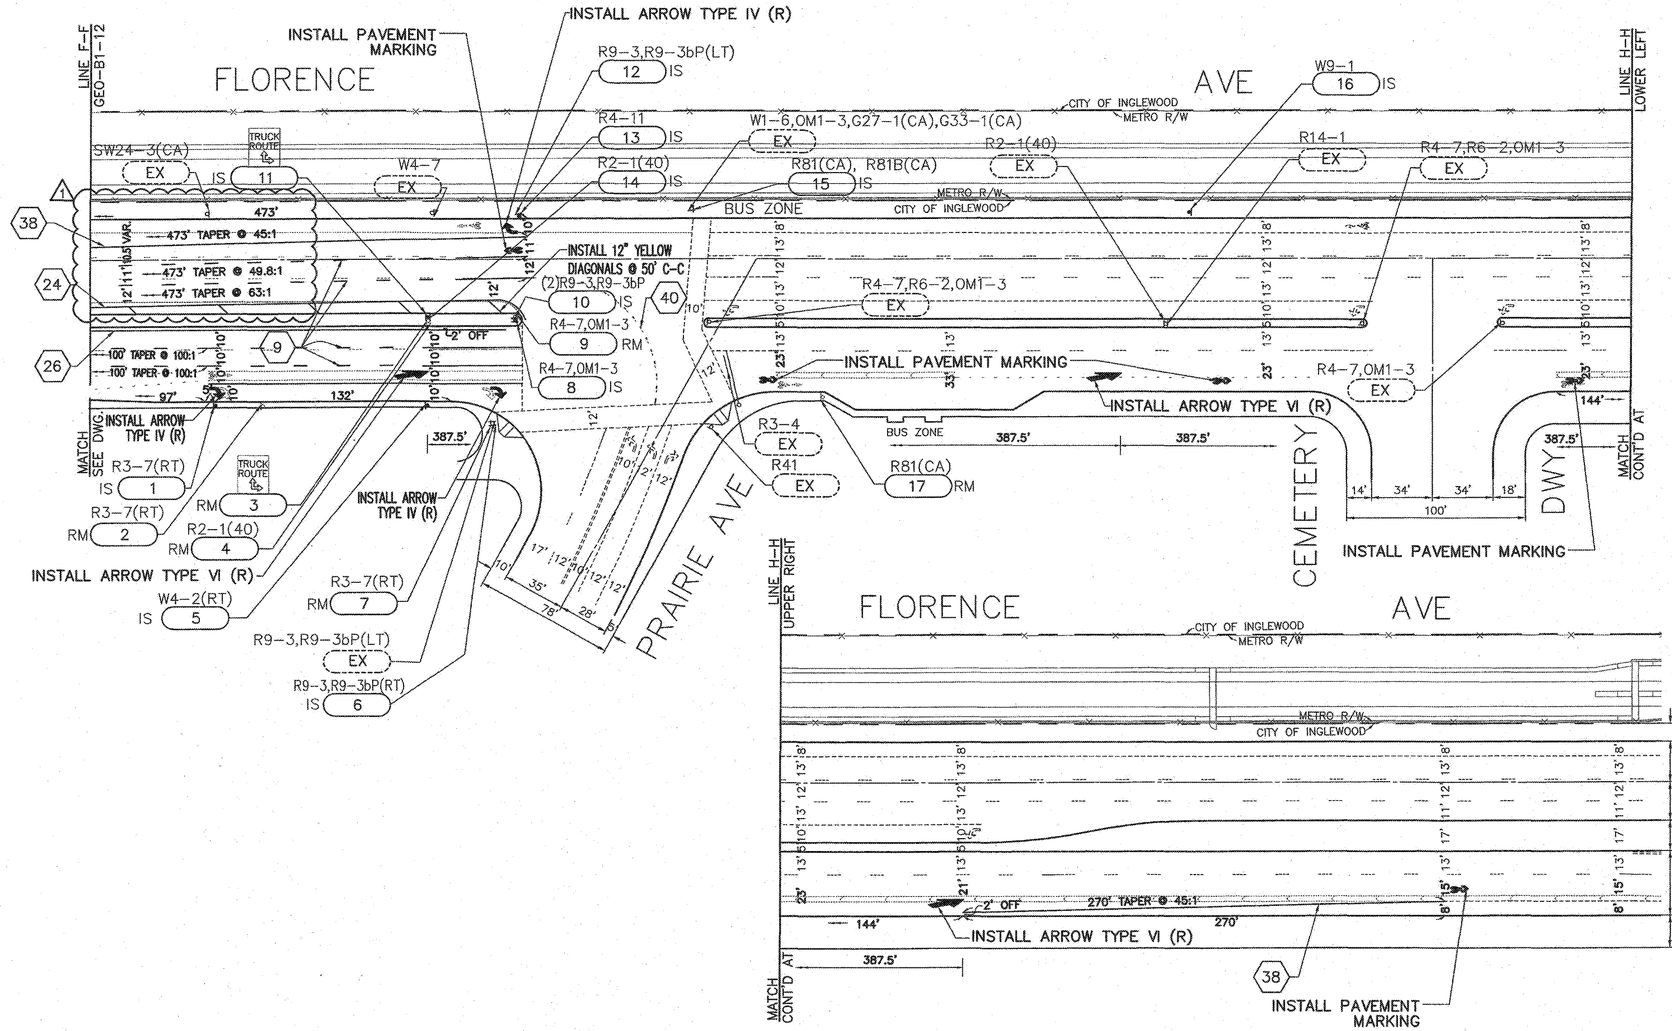

SIGNING AND STRIPING GENERAL NOTES:

1. TRAFFIC SIGNING AND STRIPING SHALL CONFORM TO 2010 CALTRANS STANDARD PLANS AND SPECIFICATIONS, THE CALIFORNIA MANUAL ON UNIFORM TRAFFIC CONTROL DEVICES (CA MUTCD 2012), THESE PLANS, AND THE SPECIAL PROVISIONS.
2. NO STRIPING SHALL BE DONE WITHOUT THE APPROVAL OF THE CITY. ALL STRIPING AND SIGN LAYOUTS SHALL BE INSPECTED BY THE ENGINEER IN THE FIELD BEFORE STRIPING BEGINS. CONTACT THE PUBLIC WORKS INSPECTOR 48 HOURS BEFORE CATTRACKING TO SCHEDULE INSPECTION.
3. PAVEMENT LEGENDS SHALL BE LOCATED EIGHT FEET 8' BEHIND THE STOP BAR OR CROSSWALK.
4. ALL STENCILS USED TO INSTALL PAVEMENT LEGENDS SHALL CONFORM TO THE LATEST CALTRANS STENCILING STANDARDS EXCEPT WHEN MODIFIED BY THE CITY STANDARDS.
5. ALL STRIPING, ARROWS AND PAVEMENT LEGENDS SHALL BE THERMOPLASTIC. CURB MARKINGS SHALL BE PAINT (2 COATS).
6. CONTRACTOR SHALL INSTALL 50' 4" WHITE STRIPING ON INTERSECTION APPROACH AND DEPARTURE WITH 4"X7' WHITE LANE LINE.
7. CONTRACTOR SHALL REPAINT RED CURB AND PARKING RESTRICTIONS WHERE APPLICABLE UNLESS OTHERWISE NOTED ON THIS PLAN.

ABBREVIATIONS:

EX EXISTING
IS INSTALL ROADSIDE SIGN ON METAL POST/MAST ARM
RM REMOVE
(CA) STATE OF CALIFORNIA SIGN CODE

LEGEND:

(No.) SIGN NUMBER
(EX) EXISTING SIGN TO REMAIN
(R) SIGN SHOWN FOR REFERENCE ONLY. SEE FREEWAY SIGN PLAN FOR DETAILS.
(NO.) INSTALL STRIPING DETAIL

PACKAGE B-1.5

CITY OF INGLEWOOD, CALIFORNIA
PUBLIC WORKS DEPARTMENT

SUBMITTED BY/APPROVED BY:
VANESSA MUNOZ, P.E. C67693, CONSULTING TRAFFIC ENGINEER 8/15/17

PLAN SCALE:
PROFILE SCALE: VERTICAL -NONE- HORIZONTAL

THE PREPARATION OF THIS DRAWING HAS BEEN FINANCED IN PART THROUGH A GRANT FROM THE U.S. DEPARTMENT OF TRANSPORTATION, FEDERAL TRANSIT ADMINISTRATION (FTA). UNDER THE FEDERAL TRANSIT ACT OF 1964, AS AMENDED, AND IN PART BY THE TAXES OF THE CITIZENS OF LOS ANGELES COUNTY AND OF THE STATE OF CALIFORNIA.

REV	DATE	BY	APP	REG NO	EXPIRES	SEAL HOLDER	DESCRIPTION
1	7/20/17	M.G.	N.B.	C-65608	9/30/17		NDC 202
0	12/18/15			C-65608	9/30/17	NOAH BUSCH	AFC SUBMITTAL

DESIGNED BY V.Y. HUANG
DRAWN BY K.M. HONG
CHECKED BY M.A. GAYTAN
IN CHARGE N.L. BUSCH
DATE 12/18/2015

A SIGNED & SEALED ORIGINAL OF REV 0 OF THIS DRAWING IS MAINTAINED BY WSCC

LOS ANGELES COUNTY METROPOLITAN TRANSPORTATION AUTHORITY
Metro
WALSH-SHEA CORRIDOR CONSTRUCTORS
9323 Bellanca Ave.
Los Angeles, California 90045
HNTB
STEVE WHITAKER
APPROVED
V&A INC.
530 S. HEWITT ST. SUITE 121
LOS ANGELES, CA 90013
213.972.9700
NOAH BUSCH
SUBMITTED

CRENSHAW/LAX TRANSIT CORRIDOR PROJECT
SIGNING & STRIPING MODIFICATION FLORENCE AVENUE & CENTINELA AVENUE

CONTRACT NO C0988
DRAWING NO GEO-B1-12A
REV 1
SCALE 1"=40'
SHEET NO

CADD PROJECT FILE NAME: C:\cadd\lw\lloera\vdc\d0278037\C0988PMB12A.dwg Jul 20, 2017 2:45pm lloera
REVISION DATES (DESIGN STAGE ONLY)
Sheet Version 2.01
Plotted by: $USER$ $DATE$ $FILES$