


NO.	DESCRIPTION	DATE

HOLLYWOOD PARK RESIDENTIAL - MU-10
INGLEWOOD, CALIFORNIA
**HOLLYWOOD PARK RETAIL AND
COMMERCIAL INVESTORS, LLC**

**HORIZONTAL CONTROL
PLAN**
NOT FOR CONSTRUCTION

THIS SET OF CONSTRUCTION DOCUMENTS HAS BEEN PREPARED FOR THE CONSTRUCTION OF AN APARTMENT PROJECT.
C1.02
2017-083-01
JOB NUMBER
1" = 20'
SCALE
PLOT PLAN RESUBMITTAL
0021-2018
DATE

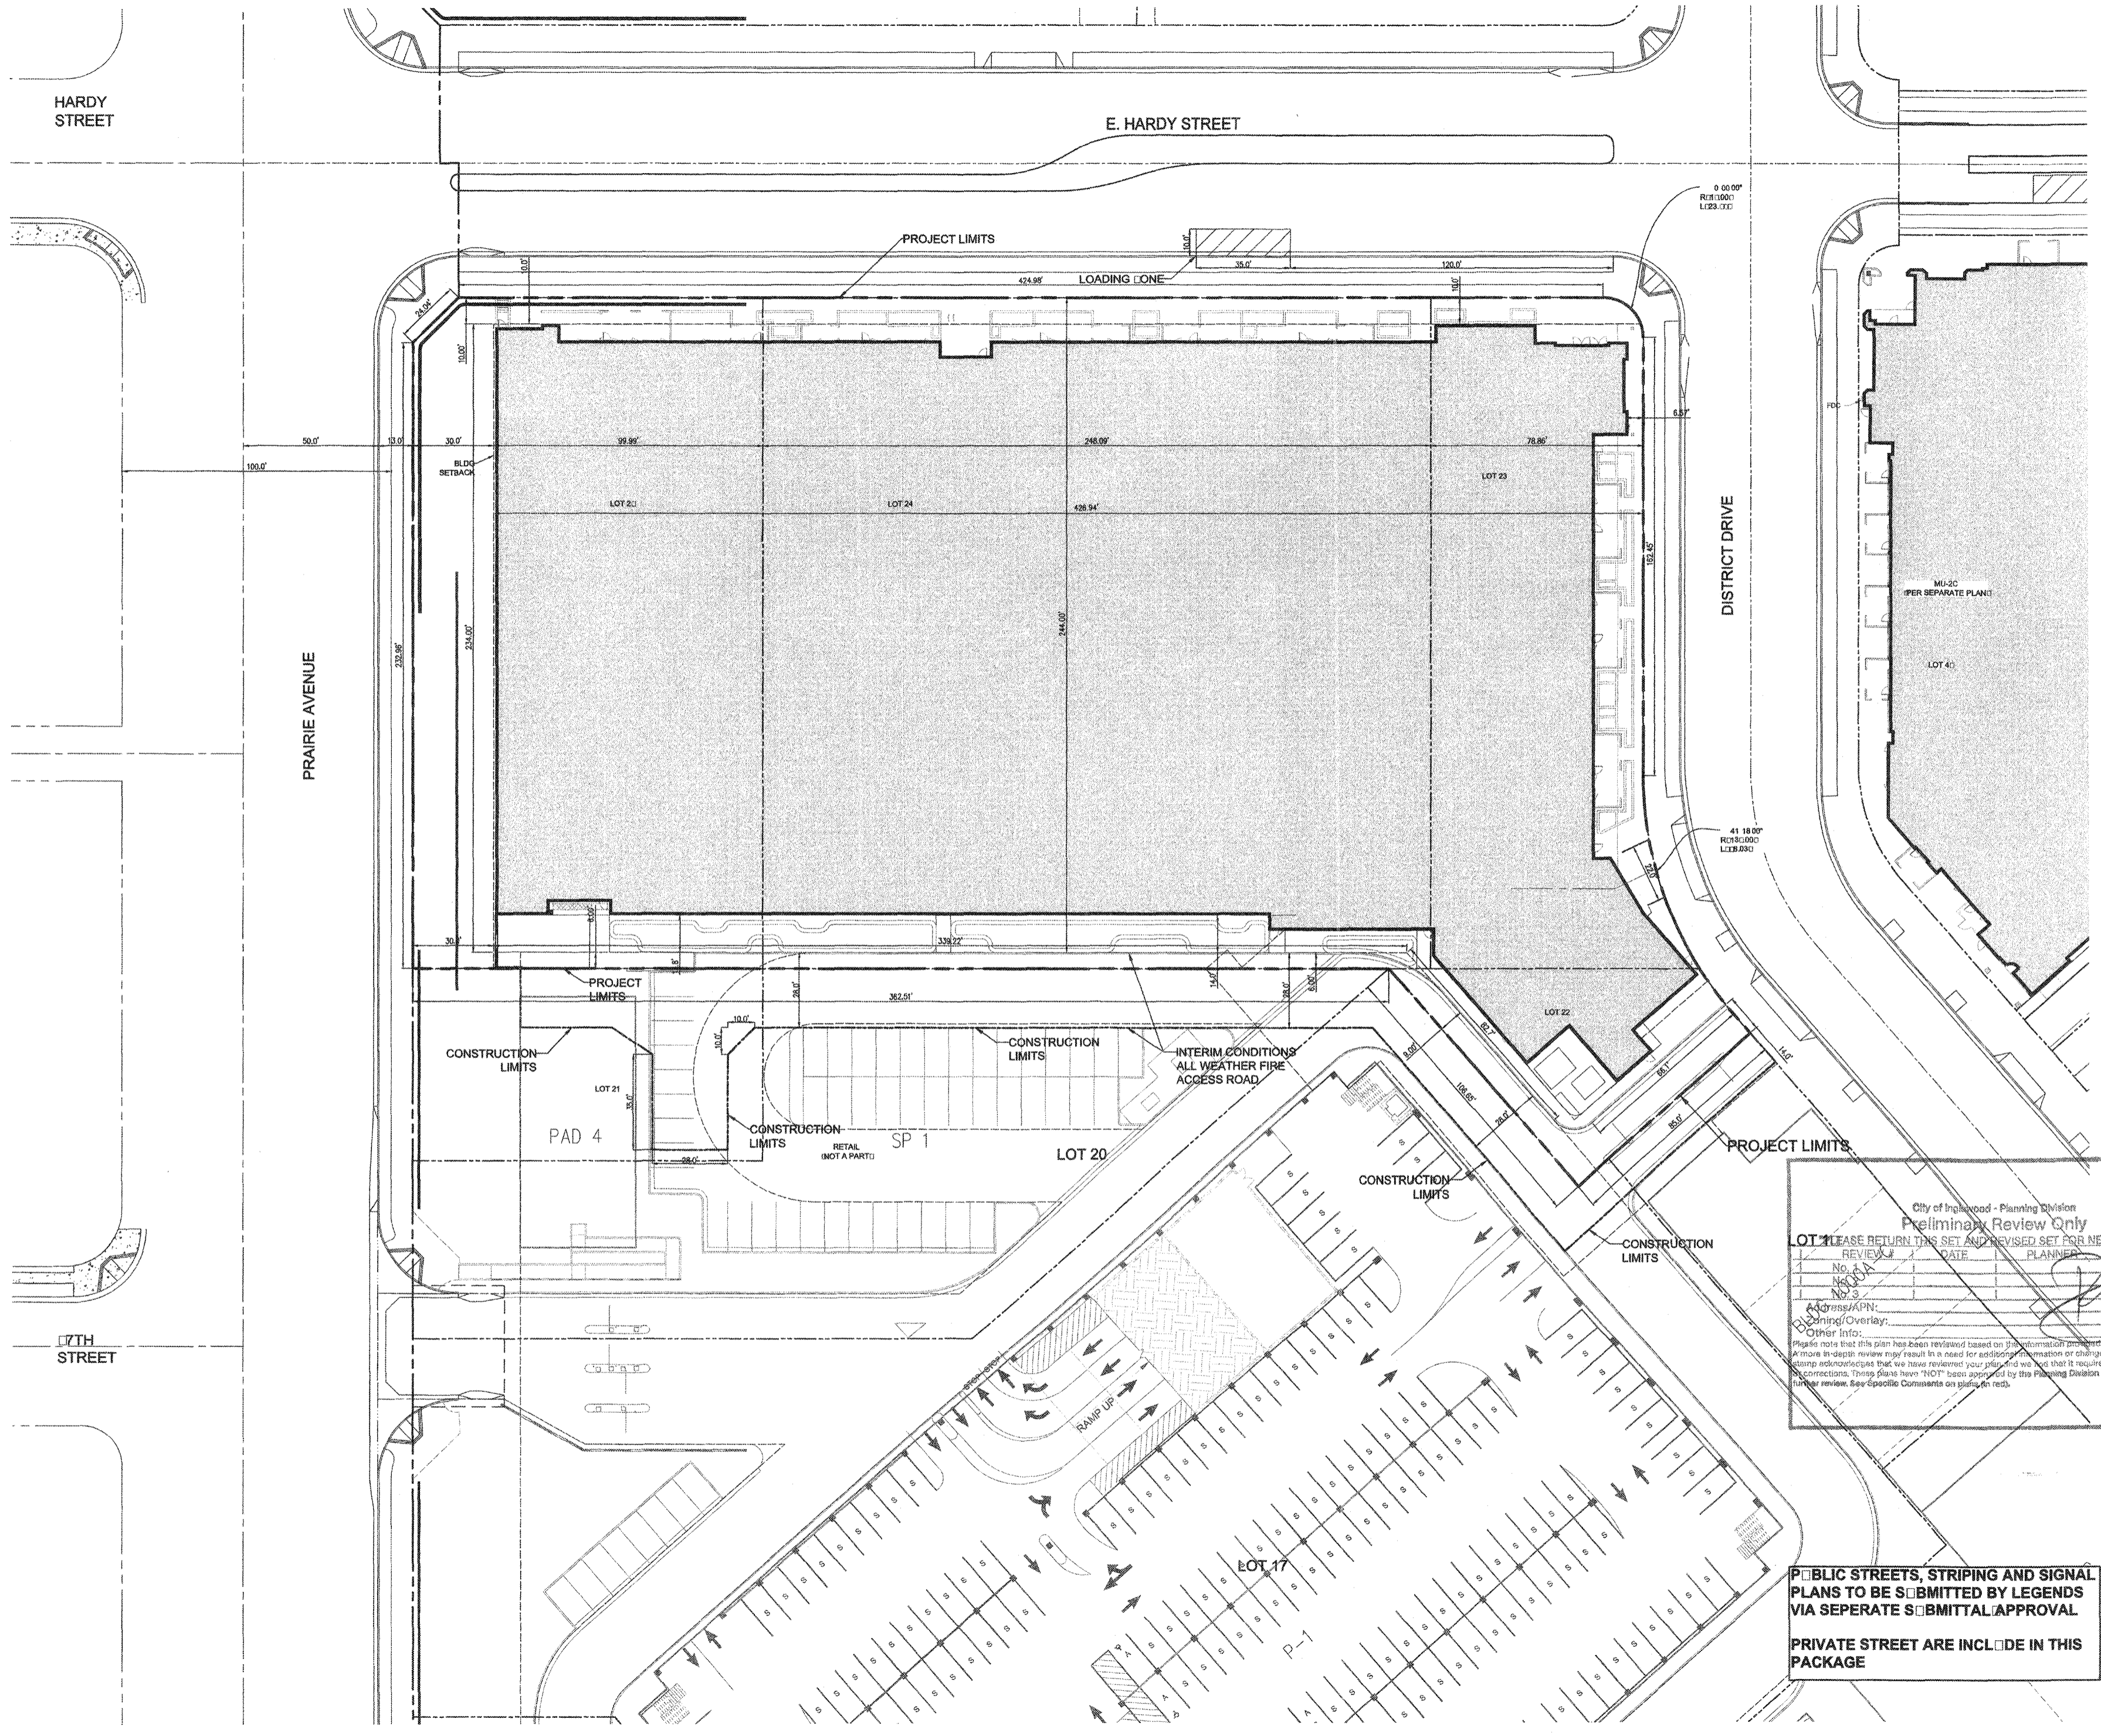

City of Inglewood - Planning Division
Preliminary Review Only
PLEASE RETURN THIS SET AND REVISED SET FOR NEXT REVIEW

REVIEW #	DATE	PLANNER
No. 1		
No. 2		
No. 3		

Address/APN: _____
Zoning/Overlay: _____
Other Info: _____

Please note that this plan has been reviewed based on the information provided by you, the applicant. A more in-depth review may result in a need for additional information or changes to your plan. This stamp indicates that we have reviewed your plan and we note that it requires additional information/corrections. These plans have "NOT" been approved by the Planning Division and will require further review. See Specific Comments on plan, if any.

**PUBLIC STREETS, STRIPING AND SIGNAL
PLANS TO BE SUBMITTED BY LEGENDS
VIA SEPARATE SUBMITTAL/APPROVAL**
**PRIVATE STREET ARE INCLUDE IN THIS
PACKAGE**

