## GENERAL PLANTING NOTES

- TREE LOCATIONS MAY BE ADJUSTED TO AVOID CONFLICTS WITH UNDERGROUND UTILITIES. CONSULT WITH LANDSCAPE ARCHITECT OR OWNER'S REPRESENTATIVE PRIOR TO ADJUSTMENT OF TREE LOCATIONS, ESPECIALLY THOSE ARRANGED ON A SPECIFIED MODULE OR IN A GRID
- 2. ALL TREES LOCATED WITHIN 3' OF PAVEMENT OR STRUCTURES ARE TO HAVE ROOT CONTROL BARRIERS INSTALLED AT TIME OF PLANTING. UNLESS OTHERWISE SPECIFIED, A 12' LONG X 18" DEEP LINEAR BARRIER SHALL BE INSTALLED AT EDGE OF PAVEMENT/STRUCTURE, WITH LENGTH CENTERED AT THE TREE TRUNK.
- 3. NURSERY STAKES ARE TO BE REMOVED AFTER PLANTING TREES AND STAKING OR GUYING AS
- CONTRACTOR IS RESPONSIBLE FOR PRUNING TREES AS DIRECTED BY LANDSCAPE ARCHITECT. NO PRUNING IS TO BE DONE UNLESS DIRECTED.
- 5. MULCH ALL AREAS (EXCEPT TURF, SLOPES 2:1 AND GREATER, AND AS NOTED ON PLANS) WITH 2"
- WHERE GROUNDCOVER IS SHOWN ON PLANS; GROUNDCOVER PLANTING CONTINUES UNDER SHRUBS & TREES AT SPECIFIED SPACING. DO NOT PLANT GROUNDCOVER IN SHRUB/TREE
- 7. THE PLANTING PLAN IS DIAGRAMMATIC. ALL PLANT LOCATIONS ARE APPROXIMATE. PLANT SYMBOLS TAKE PRECEDENCE OVER PLANT QUANTITIES SPECIFIED. QUANTITIES SHOWN ON THE PLANTING PLAN ARE APPROXIMATE AND ARE FOR OWNER INFORMATION. CONTRACTOR SHALL NOTIFY THE LANDSCAPE ARCHITECT OF DISCREPANCIES BETWEEN QUANTITIES AND THE SYMBOLS SHOWN. CONTRACTOR SHALL BE RESPONSIBLE FOR VERIFYING ALL PLANT COUNTS
- CONTRACTOR SHALL ACCOMPANY THE PROJECT AGRONOMIST TO THE SITE FOR THE PURPOSE OF TAKING SOIL SAMPLES, CONDUCTING PERCOLATION TESTS, AND REVIEWING EXISTING SITE CONDITIONS. THE APPROPRIATE QUANTITY OF SAMPLES SHALL BE VERIFIED WITH THE LANDSCAPE ARCHITECT AND AGRONOMIST. SAMPLES SHALL THEN BE TESTED AND ANALYZED FOR PERCOLATION AND AGRICULTURAL SUITABILITY AND FERTILITY BY AN ACCREDITED SOIL TESTING LABORATORY. ANALYSIS SHALL INCLUDE REVIEW AND COORDINATION WITH SPECIFICATIONS AND RECOMMENDATIONS FOR SOIL PREPARATION AND BACKFILL MIX AND SHALL BE PAID FOR BY THE CONTRACTOR AT NO COST TO THE OWNER. SUBMIT SOILS ANALYSES TO LANDSCAPE ARCHITECT FOR APPROVAL PRIOR TO SOIL PREPARATION. THIS REQUIREMENT APPLIES TO ALL SOILS AND CONDITIONS WITHIN THIS PROJECT. REFER TO SPECIFICATIONS FOR FURTHER REQUIREMENTS.
- NOTIFICATION PRIOR TO PLANTING: SEE SPECIFICATION - SHRUBS SHALL BE PLACED IN THEIR "FINAL" LOCATIONS CENTERPOINTS OF TREES SHOULD BE STAKED/FLAGGED
- 10. LANDSCAPE ARCHITECT HAS THE RIGHT TO ADJUST PLANT LOCATIONS AND SPACING UPON REVIEWING IN THE FIELD.
- 11. PLANT MATERIAL SHALL NOT BE ROOT BOUND. FIVE (5) GALLON PLANTS AND LARGER SHALL HAVE BEEN GROWN IN CONTAINERS FOR A MINIMUM OF SIX (6) MONTHS AND A MAXIMUM OF TWO (2) YEARS. PLANTS SHALL BE FURNISHED ON SITE FREE OF PESTS OR DISEASE AND EXHIBIT
- 12. ALL TREES SHALL HAVE A MINIMUM LIFE GUARANTEE OF ONE (1) YEAR OF VIGOROUS GROWTH, ALL SHRUBS SHALL HAVE A MINIMUM LIFE GUARANTEE OF SIX (6) MONTHS OF VIGOROUS
- 13. ALL GROUND COVERS SHALL BE GUARANTEED BY THE CONTRACTOR AS TO GROWTH AND HEALTH FOR A PERIOD OF SIXTY (60) DAYS AFTER COMPLETION OF MAINTENANCE PERIOD AND FINAL ACCEPTANCE. ALL SHRUBS SHALL BE GUARANTEED BY THE CONTRACTOR AS TO GROWTH AND HEALTH FOR A PERIOD OF NINETY (90) DAYS AFTER COMPLETION OF MAINTENANCE PERIOD AND FINAL ACCEPTANCE. ALL TREES SHALL BE GUARANTEED BY THE CONTRACTOR TO LIVE AND GROW IN AN ACCEPTABLE UPRIGHT POSITION FOR A PERIOD OF ONE (1) YEAR AFTER COMPLETION OF THE SPECIFIED MAINTENANCE PERIOF AND FINAL ACCEPTANCE.
- 14. THE CONTRACTOR, WITHIN FIFTEEN (15) DAYS OF WRITTEN NOTIFICATION BY THE LANDSCAPE ARCHITECT, SHALL REMOVE AND REPLACE ALL GUARANTEED PLANT MATERIALS, WHICH FOR ANY REASON FAIL TO MEET THE REQUIREMENTS OF THE GUARANTEE. REPLACMENT SHALL BE MADE WITH PLANT MATERIALS AS INDICATED OR SPECIFIED ON THE ORIGINAL PLANS, AND ALI SUCH REPLACEMENT MATERIALS SHALL BE GUARANTEED FROM THE TIME OF REPLACEMENT AS SPECIFIED FOR THE ORIGINAL MATERIAL GUARANTEE.
- 15. IF CONFLICTS ARISE BETWEEN ACTUAL SIZE OF PLANTING AREAS ON-SITE AND THOSE AREAS INDICATED ON DRAWINGS, CONTACT OWNER'S AUTHORIZED REPRESENTATIVE OR LANDSCAPE ARCHITECT FOR RESOLUTION. FAILURE TO MAKE SUCH CONFLICTS KNOWN TO OWNER'S AUTHORIZED REPRESENTATIVE IN A TIMELY FASHION MAY RESULT IN CONTRACTOR'S OWN LIABILITY TO RELOCATE PLANT MATERIALS.
- 16. CONTRACTOR SHALL MAINTAIN ALL PLANTINGS FOR A PERIOD OF NINETY (90) DAYS AFTER COMPLETION AND ACCEPTANCE BY LANDSCAPE ARCHITECT. ALL AREAS SHOULD BE KEPT
- 17. PRIOR TO END OF MAINTENANCE PERIOD, LANDSCAPE CONTRACTOR SHALL CONTACT OWNER AND ARRANGE A FINAL WALK THROUGH INSPECTION BY LANDSCAPE ARCHITECT. OWNER MUST ACCEPT ALL MAINTAINED AREAS IN WRITING PRIOR TO END OF MAINTENANCE PERIOD. OWNER SHALL BE RESPONSIBLE FOR FUTURE MAINTENANCE AFTER MAINTENANCE PERIOD AND FINAL
- 18. ALIGN AND EQUALLY SPACE IN ALL DIRECTIONS ALL TREES, SHRUBS, AND VINES AS NOTED IN
- 19. PRUNE NEWLY PLANTED TREES ONLY DIRECTED BY THE LANDSCAPE ARCHITECT.
- 20. FOR PROJECTS THAT INCLUDE LANDSCAPE WORK, THE LANDSCAPE CERTIFICATION, FORM GRN 12, SHALL BE COMPLETED PRIOR TO FINAL INSPECTION APPROVAL.
- 21. AUTOMATIC LANDSCAPE IRRIGATORS SHALL BE INSTALLED IN SUCH A WAY THAT IT DOESN'T SPRAY ON THE BUILDING OR ADJACENT PAVING.
- 22. ALL PLANTS TO BE PROPAGATED FROM DIVISION ONLY

## SOIL PREPARATION AND FINE GRADING NOTES

- FINAL GRADING SHALL BE APPROVED BY THE LANDSCAPE ARCHITECT AND CIVIL ENGINEER IN THE FIELD AFTER SOIL PREPARATION AND PRIOR TO PLANTING. ALL PLANTING AREAS SHALL BE GRADED TO THE ELEVATIONS INDICATED ON THE CIVIL ENGINEER'S PLANS.
- FINISH GRADES OF ALL SHRUB AREAS SHALL BE 1 1/2" BELOW ADJACENT CURBS, PAVEMENT, TOP PLANTER WALL, OR HEADERS. FINISH GRADES OF ALL TURF AREAS SHALL BE 1" BELOW ADJACENT CURBS, PAVEMENT, TOP OF PLANTER WALL, OR HEADERS.
- CONTRACTOR SHALL MAINTAIN A MINIMUM OF 2% DRAINAGE AWAY FROM ALL BUILDINGS. STRUCTURES, AND WALLS. FINISHED GRADES SHALL BE SMOOTHED TO ELIMINATE PUDDLING
- 4. EXCESS SOIL FROM LANDSCAPE GRADING TO BE REMOVED AND DISPOSED OF OFF-SITE BY
- REFER TO CIVIL ENGINEER'S DRAWINGS FOR GRADING AND DRAINAGE INFORMATION AND OTHER RELATED NON-LANDSCAPE WORK. VERIFY ON-SITE AND REPORT DISCREPANCIES TO LANDSCAPE ARCHITECT BEFORE START OF ANY WORK ON THIS CONTRACT.
- 6. CONTINUOUSE SOIL PREPARATION IS REQUIRE IN ALL PLANTING AREAS.
- PRIOR TO PLANTING, IRRIGATION SYSTEM SHALL BE APPROVED BY THE LANDSCAPE ARCHITECT AND BE FULLY OPERATIONAL. ALL PLANTING AREAS SHALL BE FULLY SOAKED.
- CONTRACTOR SHALL APPLY A CONTACT HERBICIDE, WHERE WEEDS ARE PRESENT, PER MANUFACTURER'S SPECIFICATIONS A MINIMUM OF TEN (10) DAYS PRIOR TO COMMENCEMENT OF ANY PLANTING OR IRRIGATION WORK. WEEDS SHALL BE ALLOWED TO COMPLETELY DIE BACK. INCLUDING THE ROOTS BEFORE PROCEEDING WITH WORK.
- 9. COMPACTED SOIL IN ALL PLANTING AREAS SHALL BE RIPPED TO A DEPTH OF EIGHTEEN (18)
- 10. SOIL FILL AND BACKFILL MIX: SEE SPECIFICATIONS.
- 11. SOIL AMENDMENTS : SEE SPECIFICATIONS.
- 12. SHRUB AND TREE BACKFILL MIX: SEE SPECIFICATIONS.
- 13. PLANT TABLETS FOR PLANT PITS: SEE SPECIFICATIONS

## SHRUB, VINE, AND GROUNDCOVER LEGEND:

Zamia furfuraces Cardboard Palm

Ficus pumila Creeping Fig

SIZE WUCOLS SPACING

SEE PLAN

5 GAL M


5 GAL M

|   | Creeping Fig  | 5 GAL | \$V\$                                   | PLAN                                    |
|---|---|-------|---|---|
| (A)                                     | Bauer's Dracaena Palm   | 5 GAL | M                                       | SEE                                     |
|   | Cordyline 'Baueri'  Echeveria 'Aftergiow'                             |       |   | PLAN                                    |
|   | Afterglow Echeveria   | 5 GAL | L                                       | PLAN                                    |
| -                                       | Phormium tenax 'Variegatum'<br>Green-Yellow New Zealand Flax          | 5 GAL | L                                       | SEE<br>PLAN                             |
| 63                                      | Woodwardia fimbriata  | 5 GAL | M                                       | SEE                                     |
| 1 X                                     | Giant Chain Fern Philodendron 'Xanadu'                                |       |   | PLAN                                    |
| LY_                                     | Philodendron Xanadu   | 5 GAL | L.                                      | PLAN                                    |
|   | Asplenium nidus<br>Bird's Nest Fern                                   | 5 GAL | M                                       | PLAN                                    |
| (4)                                     | Cissus antartica  | 5 GAL | М                                       | SEE                                     |
|   | Kangaroo Vine Asperagus densifiorus 'Myers'                           |       |   | PLAN                                    |
|   | Foxteil Fern  | 5 GAL | M                                       | PLAN                                    |
| (+)                                     | Agave 'Blue Flame'<br>Blue Flame Agave                                | 5 GAL | L                                       | PLAN                                    |
|   | Agave attenuata   | 5 GAL | L                                       | SEE                                     |
|   | Foxtail Agave  Aeonium 'Mint Saucer'                                  |       |   | PLAN                                    |
| (.)                                     | Green Aeonium   | 5 GAL | L                                       | PLAN                                    |
| •                                       | Agave desmettiana 'Variegata'<br>Variegated Dwarf Agave               | 5 GAL | Ł                                       | SEE<br>PLAN                             |
| (A)                                     | Agave 'Blue Glow'   | 5 GAL | L                                       | SEE                                     |
| 00000000                                | Blue Glow Agave<br>Senecio talinoides                                 |       |   | PLAN                                    |
| 2 2 2 2 2 2 2 2 2 2 2 2 2 2 2 2 2 2 2   | Blue Finger   | 5 GAL | L                                       | 12" O.C.                                |
| £3                                      | Polystichum munitum<br>Western Sword Fern                             | 5 GAL | M                                       | SEE<br>PLAN                             |
| XXXXXX                                  | Dietes iridioides   | 5 GAL | L                                       | 12" O.C.                                |
| XXXXX                                   | Fortnight Lily  Euonymus japonicus 'Microphyllus                      |       |   | 12 0.0.                                 |
|   | Variegatus'   | 5 GAL | M                                       | SEE<br>PLAN                             |
| 777777777                               | Variegated Boxleaf Euonymus  Rosmarinus officinalis 'Upright'         |       |   | SEE                                     |
| (6)                                     | Upright Rosemary  | 5 GAL | L                                       | PLAN                                    |
| (A) 1                                   | Festuca ovina glauca<br>Blue Fescue                                   | 5 GAL | L                                       | SEE<br>PLAN                             |
| (46)                                    | Agave parryl var. truncata  | 5 GAL | L                                       | SEE                                     |
|   | Parry's Agave  Agave victoriae-reginae                                |       |   | PLAN                                    |
|   | Queen Victoria Agave  | 5 GAL | L                                       | PLAN                                    |
|   | Bougainvillea 'Monka'<br>Co-La-La Bougainvillea                       | 5 GAL | Ł                                       | SEE<br>PLAN                             |
| (B)                                     | Oles europaes 'Little Ollie'  | 5 GAL | L                                       | SEE                                     |
|   | Little Oille Alce striets   |       |   | PLAN                                    |
| 0                                       | Coral Aloe  | 5 GAL | L                                       | PLAN                                    |
| (C)                                     | Phormium 'Platts Bleck'<br>Black New Zealand Flax                     | 5 GAL | M                                       | SEE                                     |
| 93                                      | Nassella Tenuissima   | 5 GAL | L                                       | SEE                                     |
|   | Mexican Feathergrass Senecio vitalis                                  |       |   | PLAN                                    |
| <b>B</b>                                | Narrow-leaf Chalksticks   | 5 GAL | <b>.</b>                                | PLAN                                    |
|   | Lavandula angustifolia 'Hidcota Blue'<br>Hidcote Blue Lavander        | 5 GAL | L.                                      | SEE<br>PLAN                             |
|   | Myrtus communis   | 1 GAL | L                                       | 9" O.C.                                 |
| 4                                       | Dwarf Myrtle  Dichondra argentea 'Silver Falls'                       |       |   | SEE                                     |
|   | Silver Falls Dichondra  | 1 GAL | L                                       | PLAN                                    |
| <b>9</b>                                | Senecio rowleyanus String of Pearls                                   | 1 GAL | L                                       | PLAN                                    |
|   | Leymus condensatus 'Canyon Prince'<br>Native Blue Rve                 | 5 GAL | L                                       | 36" O.C.                                |
| 000000000000000000000000000000000000000 | Juncus patens 'Elk Blue'  |       | *************************************** | *************************************** |
| 000000000000000000000000000000000000000 | Elk Blue California Gray Rush   | 5 GAL | L                                       | 18" O.C.                                |
|   | Muhlenbergia capillaris<br>Gulf muhly Grass                           | 5 GAL | М                                       | 24" O.C.                                |
|   | Muhlenbergia rigens   | 5 GAL | L                                       | 24" O.C.                                |
|   | Deer Grass Pennisetum alopecuroides                                   |       |   |   |
| + + + + +                               | Dwarf Fountain Grass  | 5 GAL | M                                       | 12° O.C.                                |
|   | Trachelospermum jasminoides<br>Star Jasmine                           | 5 GAL | M                                       | PLAN                                    |
|   | Westringia 'Grey Box'   | E CA  | (                                       | SEE                                     |
| (D)                                     | Dwarf Coast Rosemary  | 5 GAL | L                                       | PLAN                                    |
| (E)                                     | Euonymus fortunei 'Emeraid Galety'<br>White Variegated Winter Creeper | 5 GAL | M                                       | SEE                                     |
| E                                       | Dietes bicolor  | 5 GAL | L                                       | SEE                                     |
| (F)                                     | Fortnight Lily  | JOAL  | <u>.</u>                                | PLAN                                    |
| ( <b>G</b> )                            | <i>lris douglasiana</i><br>Douglas Iris                               | 5 GAL | L                                       | SEE<br>PLAN                             |
| (H)                                     | Dianella tasmanica 'Variegata'  | 5 GAL | M                                       | SEE                                     |
|   | Variagated Flax Lily  Pittosporum crassifolium 'Compacta'             |       |   | PLAN                                    |
|   | Dwarf Karo  | 5 GAL | M                                       | PLAN                                    |
| J                                       | Ligustrum japonicum<br>Japanese Privet                                | 5 GAL | M                                       | SEE<br>PLAN                             |
| (K)                                     | Gardenia jasminoides 'White Gern'                                     | 5 GAL | м                                       | SEE                                     |
|   | White Gem Gardenia Myoporum parvifolium 'Prostratum'                  |       |   | PLAN                                    |
| L                                       | Myoporum  | 5 GAL | L.                                      | PLAN                                    |
| (M)                                     | Prunus caroliniana<br>Carolina Cherry Laurel, Column                  | 5 GAL | M                                       | SEE<br>PLAN                             |
| N                                       | Euonymus fortunel 'Colorate'<br>Purpleteaf Winter Creeper             | 5 GAL | М                                       | SEE<br>PLAN                             |
| 0                                       | Rhapiolepis indica  | 5 001 |   | SEE                                     |
|   | Indian Hawthome   | 5 GAL | L                                       | PLAN                                    |
| (P)                                     | Carlssa macrocarpa 'Tuttle'<br>Dwarf Netal Plum                       | 5 GAL | L.                                      | PLAN                                    |
| (Q)                                     | Dianella revoluta<br>Little Rev Flax Lily                             | 5 GAL | L                                       | SEE<br>PLAN                             |
| (R)                                     | Carex pansa   | S CAL | 8.2                                     | SEE                                     |
|   | California Meadow Sedge   | 5 GAL | M                                       | PLAN                                    |
| S                                       | Beccharis 'Twin Peaks'<br>Coyote Brush                                | 5 GAL | L                                       | SEE<br>PLAN                             |
| (T)                                     | Sedum 'Cape Blanco'<br>Capa Blanco Stonecrop                          | 5 GAL | L.                                      | SEE                                     |
|   | ACESTIC CONTRACTO   |       | ***                                     | PLAN                                    |
|   |   |       |   |   |

| (U) Ribes 'Spooner's Mesa' Evergreen Currant |   | 5 GAL | ٧ |
|--|---|-------|---|
| V  | Satureja douglasii<br>Yerba Buena                             | 5 GAL | ٨ |
| (W)  | Casuarina 'Cousin Itt'<br>Prostrate Swamp Oak                 | 5 GAL | L |
| (X)  | Pittosporum 'Golf Ball'<br>Golf Ball Kohuhu                   | 5 GAL | ٨ |
| Ŷ  | Rosmarinus 'Gold Dusi'<br>Gold Dust Rosemary                  | 5 GAL | Ł |
| (Z)  | Salvia 'Santa Barbara'<br>Santa Barbara Sage                  | 5 GAL | l |
| (1)  | Sollys heterophylia<br>Australian Bluebell Creaper            | 5 GAL | ı |
|  | Agepenthus africanus<br>Lily of the Nile                      | 5 GAL | A |
|  | Carex divulsa<br>Berkeley Sedge                               | 5 GAL | ŧ |
|  | Rosa alba 'White Rose of York'<br>White Rose                  | 5 GAL | ٨ |
|  | Nerium oleander<br>Oleander                                   | 5 GAL | į |
|  | Pittosporum tenuifolium 'Silver Sheen'<br>Silver Sheen Kohuhu | 5 GAL | A |

## TREE I EGEND

| SYMBOL    | BOTANICAL NAME "COMMON<br>NAME"                     | SIZE | WUCOLS | COUN |
|-----------|---|------|--------|------|
| **        | Archontophoenix<br>cunninghamiana<br>King Palm      | 36"  | М      | 23   |
|           | Trachycarrpus fortunel<br>Windmill Palm             | 36"  | М      | 11   |
| _(**)     | Strelitzia Nicolai<br>Giant Bird of Paradise        | 36"  | М      | 34   |
| 000       | Cercidium Desert Museum<br>Desert Museum Palo Verde | 36"  | VŁ     | 13   |
| ~ ( ) ( ) | Chilopsis linearis<br>Desert Willow                 | 36"  | VI.    | 4    |
|           | Arbutus unedo<br>Strawberry Tree                    | 36°  | L      | 3    |
|           | Agonis fiexuosa<br>Peppermint Willow Tree           | 36*  | L      | 4    |
| Same      | Alnus rhombifolia<br>White Aider                    | 36"  | L      | 4    |
| (°)       | Tipuana tipu<br>Tipu Tree                           | 36"  | L      | 14   |
|           | Pyrus calleryana 'chanticleer'<br>Chanticli Pear    | 36*  | М      | 4    |
|           | Salix gooddingil<br>Goodding's Black Willow         | 36"  | н      | 6    |
| ( )       | Olea europaea 'Majestic Beauty'<br>Olive Tree       | 36"  | L      | 1    |

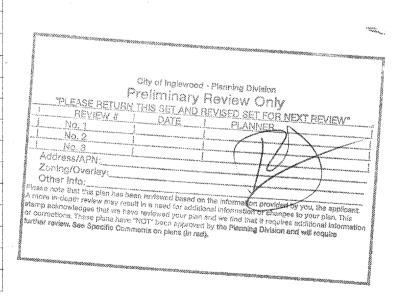



HOLLYWOOD PARK RESIDENTIAL - MU-10

& NOT

SHEDULE.

PLANTING SC

E &

INGLEWOOD, CALIFORNIA HOLLYWOOD PARK RETAIL A COMMERCIAL INVESTORS, L

NOT FOR CONSTRUCTION

WILSON

MEANY

PLOT PLAN RESUBMITTAL ISSUEDAS

