



DATE: \_\_\_\_\_  
DESCRIPTION: \_\_\_\_\_  
REVISION: \_\_\_\_\_

HOLLYWOOD PARK RESIDENTIAL - MU-10  
INGLEWOOD, CALIFORNIA  
HOLLYWOOD PARK RETAIL AND  
COMMERCIAL INVESTORS, LLC

LANDSCAPE ENLARGEMENT  
PLAN LEVEL 01 (STREET)  
NOT FOR CONSTRUCTION


THIS SET OF CONSTRUCTION  
DOCUMENTS HAS BEEN  
PREPARED FOR THE  
CONSTRUCTION OF AN  
APARTMENT PROJECT.

**LP3.02**


2017-083-01  
JOB NUMBER

SCALE  
PLOT PLAN  
RESUBMITTAL

REVISED BY  
06-21-2018  
DATE

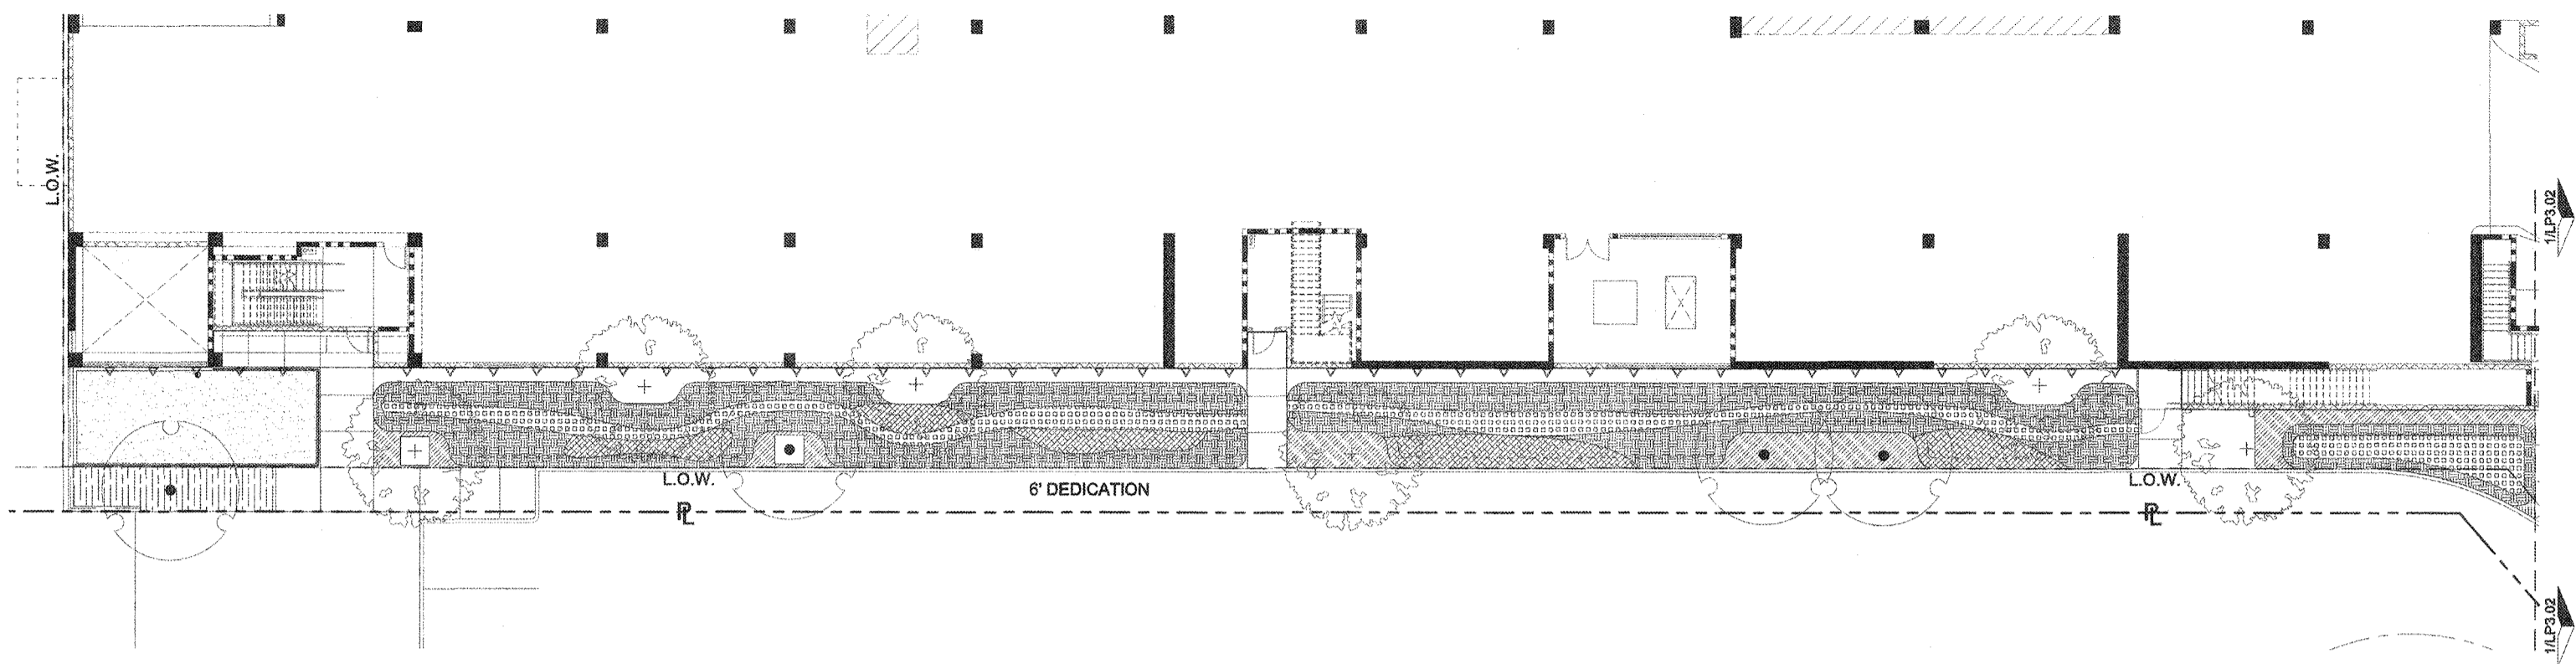

**2** LANDSCAPE CONSTRUCTION ENLARGEMENT PLAN LEVEL 01 (STREET)  
SCALE: 3/32" = 1'-0"

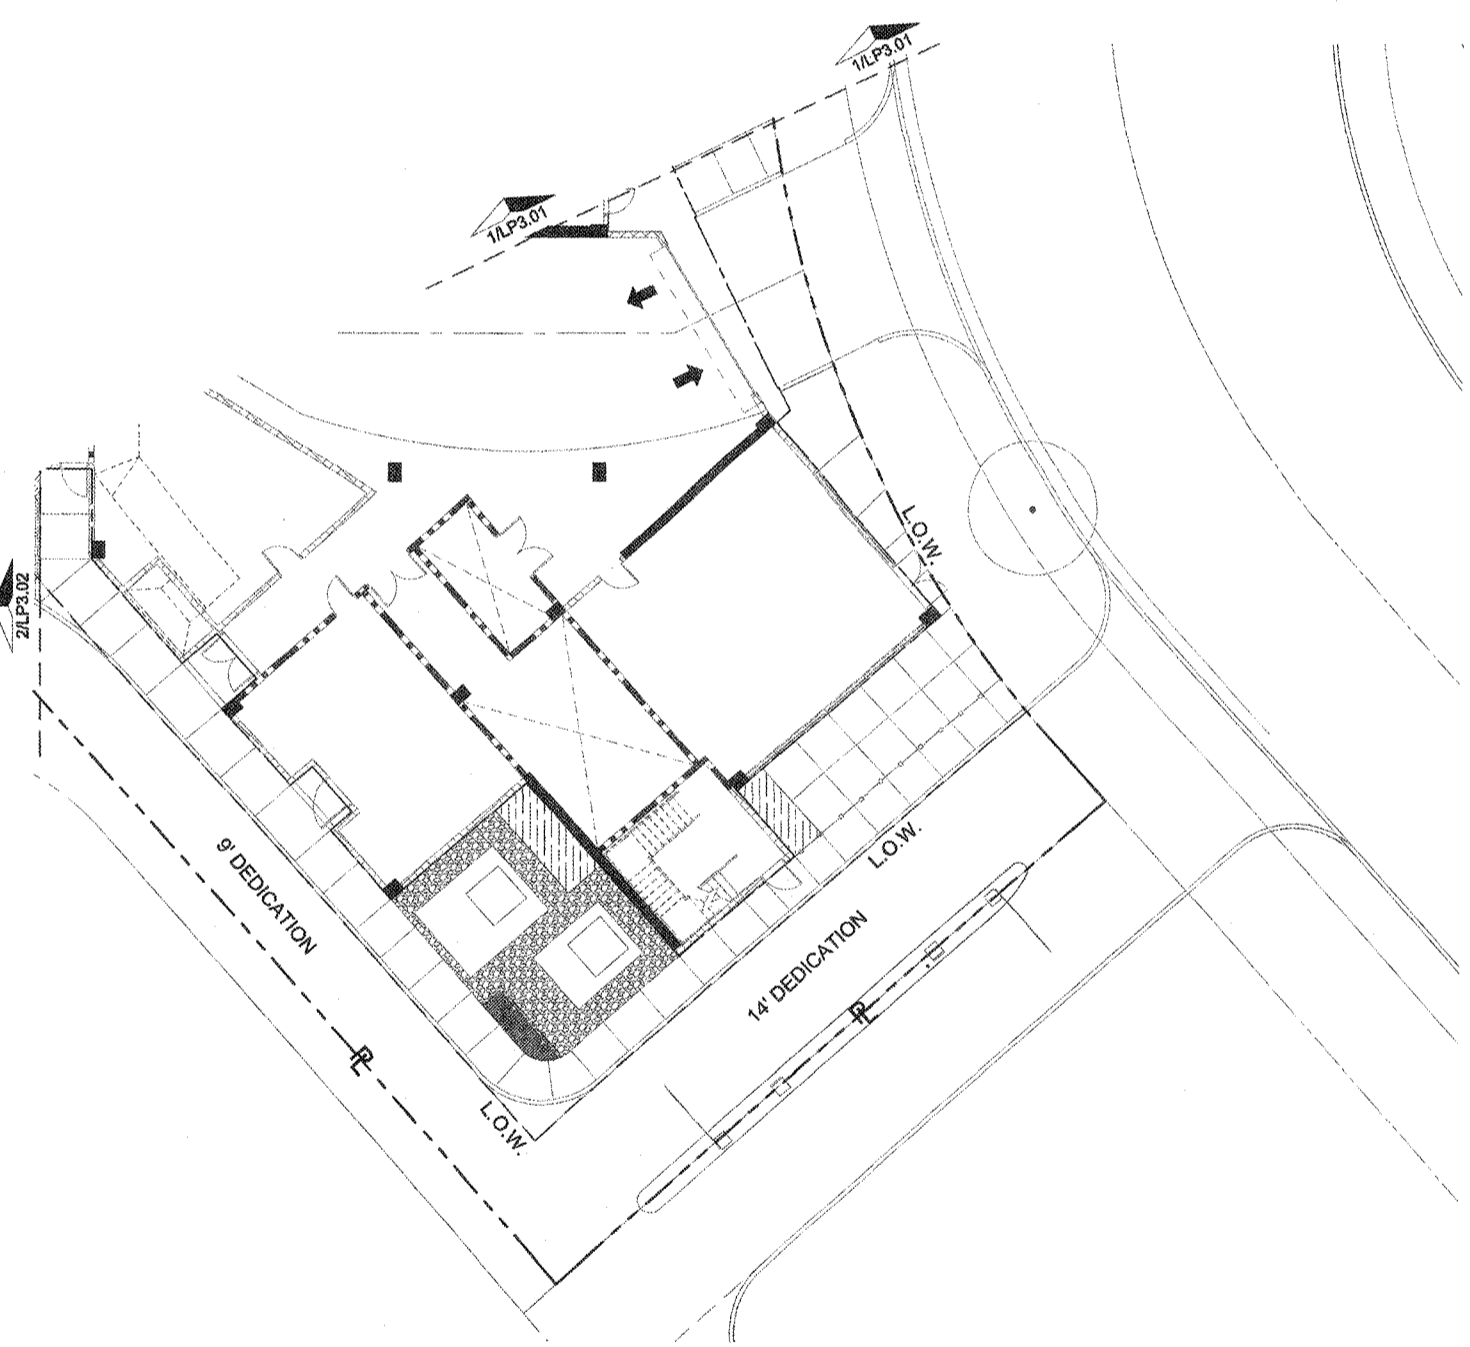

**1** LANDSCAPE CONSTRUCTION ENLARGEMENT PLAN LEVEL 01 (STREET)  
SCALE: 3/32" = 1'-0"

City of Inglewood - Planning Division  
Preliminary Review Only  
"PLEASE RETURN THIS SET AND REVISED SET FOR NEXT REVIEW"  
REVIEW # DATE PLANNED  
No. 1  
No. 2  
No. 3  
Address/APN:  
Zoning/Overlay:  
Other Info:  
Please note that this plan has been reviewed based on the information provided by you, the applicant. A more in-depth review may result in a need for additional information. We are not responsible for any omissions or errors. These drawings have been reviewed and approved for your plan. This approval does not constitute a final approval. Further review and approval by the Planning Division will require further review. See Specific Comments on plans (in red).

SHRUB, VINE, AND GROUNDCOVER LEGEND:

SYMBOL	BOTANICAL NAME "COMMON NAME"	SIZE	WUCOLS	SPACING
(Symbol)	Zamia furfuracea Cardboard Palm	5 GAL	M	SEE PLAN
(Symbol)	Ficus pumila Creeping Fig	5 GAL	M	SEE PLAN
(Symbol)	Bauer's Dracaena Palm Cordyline 'Bauer'	5 GAL	M	SEE PLAN
(Symbol)	Echovnia 'Afterglow' Afterglow Echeveria	5 GAL	L	SEE PLAN
(Symbol)	Phormium tenax 'Variegatum' Green-Yellow New Zealand Flax	5 GAL	L	SEE PLAN
(Symbol)	Woodwardia fimbriata Giant Chain Fern	5 GAL	M	SEE PLAN
(Symbol)	Philodendron 'Xanadu' Philodendron Xanadu	5 GAL	L	SEE PLAN
(Symbol)	Asplenium nidus Bird's Nest Fern	5 GAL	M	SEE PLAN
(Symbol)	Cissus antarctica Kangaroo Vine	5 GAL	M	SEE PLAN
(Symbol)	Asparagus densiflorus 'Myers' Foxtail Fern	5 GAL	M	SEE PLAN
(Symbol)	Agave 'Blue Flame' Blue Flame Agave	5 GAL	L	SEE PLAN
(Symbol)	Agave attenuata Foxtail Agave	5 GAL	L	SEE PLAN
(Symbol)	Aeonium 'Mint Sauce' Green Aeonium	5 GAL	L	SEE PLAN
(Symbol)	Agave desmetiana 'Variegata' Variegated Dwarf Agave	5 GAL	L	SEE PLAN
(Symbol)	Agave 'Blue Glow' Blue Glow Agave	5 GAL	L	SEE PLAN
(Symbol)	Senecio laetinioides Blue Finger	5 GAL	L	12" O.C.
(Symbol)	Polystichum munitum Western Sword Fern	5 GAL	M	SEE PLAN
(Symbol)	Dietes indicoides Footprint Lily	5 GAL	L	12" O.C.
(Symbol)	Euonymus japonicus 'Microphyllus' Variegated Boxleaf Euonymus	5 GAL	M	SEE PLAN
(Symbol)	Rosmarinus officinalis 'Upright' Upright Rosemary	5 GAL	L	SEE PLAN
(Symbol)	Festuca ovina glauca Blue Fescue	5 GAL	L	SEE PLAN
(Symbol)	Agave parryi var. truncata Parry's Agave	5 GAL	L	SEE PLAN
(Symbol)	Agave victoriae-reginae Queen Victoria Agave	5 GAL	L	SEE PLAN
(Symbol)	Bougainvillea 'Monika' Co-La-La Bougainvillea	5 GAL	L	SEE PLAN
(Symbol)	Olea europaea 'Little Ollie' Little Ollie	5 GAL	L	SEE PLAN
(Symbol)	Aloe striata Coral Aloe	5 GAL	L	SEE PLAN
(Symbol)	Phormium 'Platts Black' Black New Zealand Flax	5 GAL	M	SEE PLAN
(Symbol)	Nassella tenuissima Mexican Feathergrass	5 GAL	L	SEE PLAN
(Symbol)	Senecio vitifolius Narrow-leaf Chalkstick	5 GAL	L	SEE PLAN
(Symbol)	Lavandula angustifolia 'Hidcote Blue' Hidcote Blue Lavender	5 GAL	L	SEE PLAN
(Symbol)	Myrtus communis Dwarf Myrtle	1 GAL	L	9" O.C.
(Symbol)	Dichondra argentea 'Silver Falls' Silver Falls Dichondra	1 GAL	L	SEE PLAN
(Symbol)	Senecio rowleyanus String of Pearls	1 GAL	L	SEE PLAN
(Symbol)	Leymus condensatus 'Canyon Prince' Native Blue Rye	5 GAL	L	36" O.C.
(Symbol)	Juncus patens 'Elk Blue' Elk Blue California Gray Rush	5 GAL	L	18" O.C.
(Symbol)	Muhlenbergia capillaris Gulf muhly Grass	5 GAL	M	24" O.C.
(Symbol)	Muhlenbergia rigens Deer Grass	5 GAL	L	24" O.C.
(Symbol)	Pennisetum alopecuroides Dwarf Fountain Grass	5 GAL	M	12" O.C.
(Symbol)	Trachelospermum jasminoides Star Jasmine	5 GAL	M	SEE PLAN
(Symbol)	Weepingia 'Grey Box' Dwarf Coast Rosemary	5 GAL	L	SEE PLAN
(Symbol)	Euonymus fortunei 'Emerald Gaiety' White Variegated Winter Creeper	5 GAL	M	SEE PLAN
(Symbol)	Dietes bicolor Footprint Lily	5 GAL	L	SEE PLAN
(Symbol)	Iris douglasiana Douglas Iris	5 GAL	L	SEE PLAN
(Symbol)	Dianella tasmanica 'Variegata' Variegated Flax Lily	5 GAL	M	SEE PLAN

(Symbol)	Pittosporum crassifolium 'Compacta' Dwarf Karo	5 GAL	M
(Symbol)	Ligustrum japonicum Japanese Privet	5 GAL	M
(Symbol)	Gardenia jasminoides 'White Gem' White Gem Gardenia	5 GAL	M
(Symbol)	Myoporum parvifolium 'Prostratum' Myoporum	5 GAL	L
(Symbol)	Prunus caroliniana Carolina Cherry Laurel, Column	5 GAL	M
(Symbol)	Euonymus fortunei 'Colorata' Purpleleaf Winter Creeper	5 GAL	M
(Symbol)	Rhapidolepia indica Indian Hawthorne	5 GAL	L
(Symbol)	Carex macrocarpa 'Tulle' Dwarf Natal Palm	5 GAL	L
(Symbol)	Dianella arifolia Little Rav Flax Lily	5 GAL	L
(Symbol)	Carex pansa California Meadow Sedge	5 GAL	M
(Symbol)	Baccharis 'Twin Peaks' Coyote Brush	5 GAL	L
(Symbol)	Sedum 'Cape Blanco' Cape Blanco Stonecrop	5 GAL	L
(Symbol)	Ribes 'Spooners' Moss' Evergreen Currant	5 GAL	VL
(Symbol)	Satureja douglasii Yerba Buena	5 GAL	M
(Symbol)	Casuarina 'Cousin III' Prostrate Swamp Oak	5 GAL	L
(Symbol)	Pittosporum 'Golf Ball' Golf Ball Kohuhu	5 GAL	M
(Symbol)	Rosmarinus 'Gold Dust' Gold Dust Rosemary	5 GAL	L
(Symbol)	Salvia 'Santa Barbara' Santa Barbara Sage	5 GAL	L
(Symbol)	Soliva heterophylla Australian Bluebell Creeper	5 GAL	L
(Symbol)	Agapanthus africanus Lily of the Nile	5 GAL	M
(Symbol)	Carex divisa Berkeley Sedge	5 GAL	L
(Symbol)	Rosa alba 'White Rose of York' White Rose	5 GAL	M
(Symbol)	Nerium oleander Oleander	5 GAL	L
(Symbol)	Pittosporum tenuifolium 'Silver Sheen' Silver Sheen Kohuhu	5 GAL	M

TREE LEGEND:

SYMBOL	BOTANICAL NAME "COMMON NAME"	SIZE	WUCOLS	COUNT
(Symbol)	Archontophoenix cunninghamiana King Palm	36"	M	23
(Symbol)	Trachycarpus fortunei Windmill Palm	36"	M	11
(Symbol)	Streptocarpus 'Nicoia' Giant Bird of Paradise	36"	M	34
(Symbol)	Cercidium Desert Museum Desert Museum Palo Verde	36"	VL	13
(Symbol)	Chilopsis linearis Desert Willow	36"	VL	4
(Symbol)	Artibeus umedo Strawberry Tree	36"	L	3
(Symbol)	Agonis flexuosa Peppermint Willow Tree	36"	L	4
(Symbol)	Alnus rhombifolia White Alder	36"	L	4
(Symbol)	Tipuana tipu Tipu Tree	36"	L	14
(Symbol)	Pyrus calleryana 'chandlerae' Chandler Pear	36"	M	4
(Symbol)	Salix gooddingii Goodding's Black Willow	36"	H	6
(Symbol)	Olea europaea 'Majestic Beauty' Olive Tree	36"	L	1

