



3 LANDSCAPE ENLARGEMENT PLAN LEVEL 2 (PODIUM)  
SCALE: 1/8" = 1'-0"

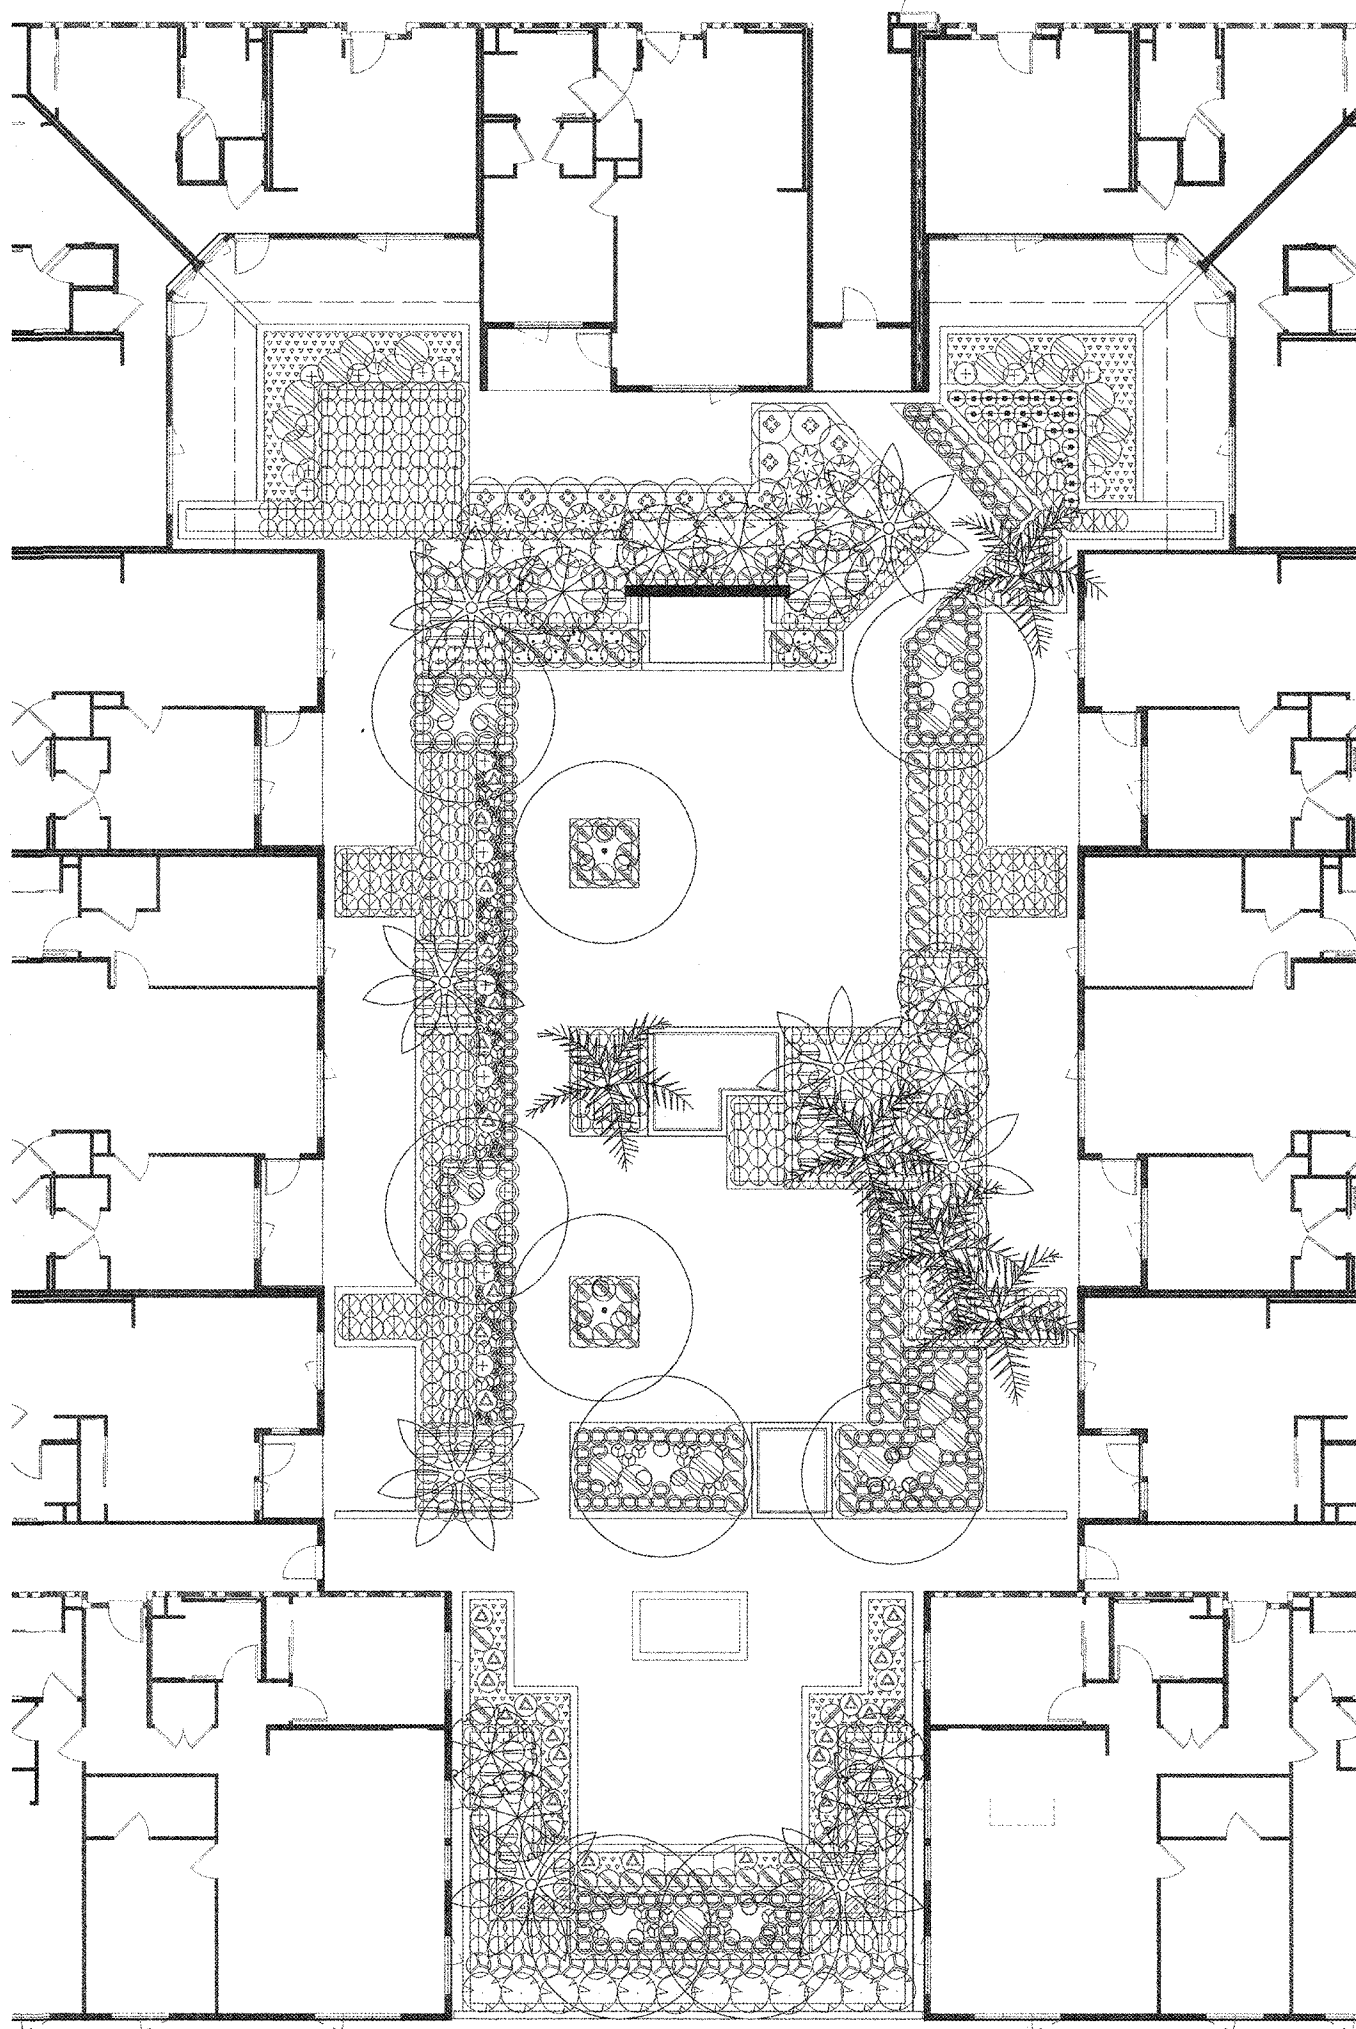

2 LANDSCAPE PLANTING PLAN LEVEL 02 (PODIUM) WEST COURTYARD  
SCALE: 1/8" = 1'-0"

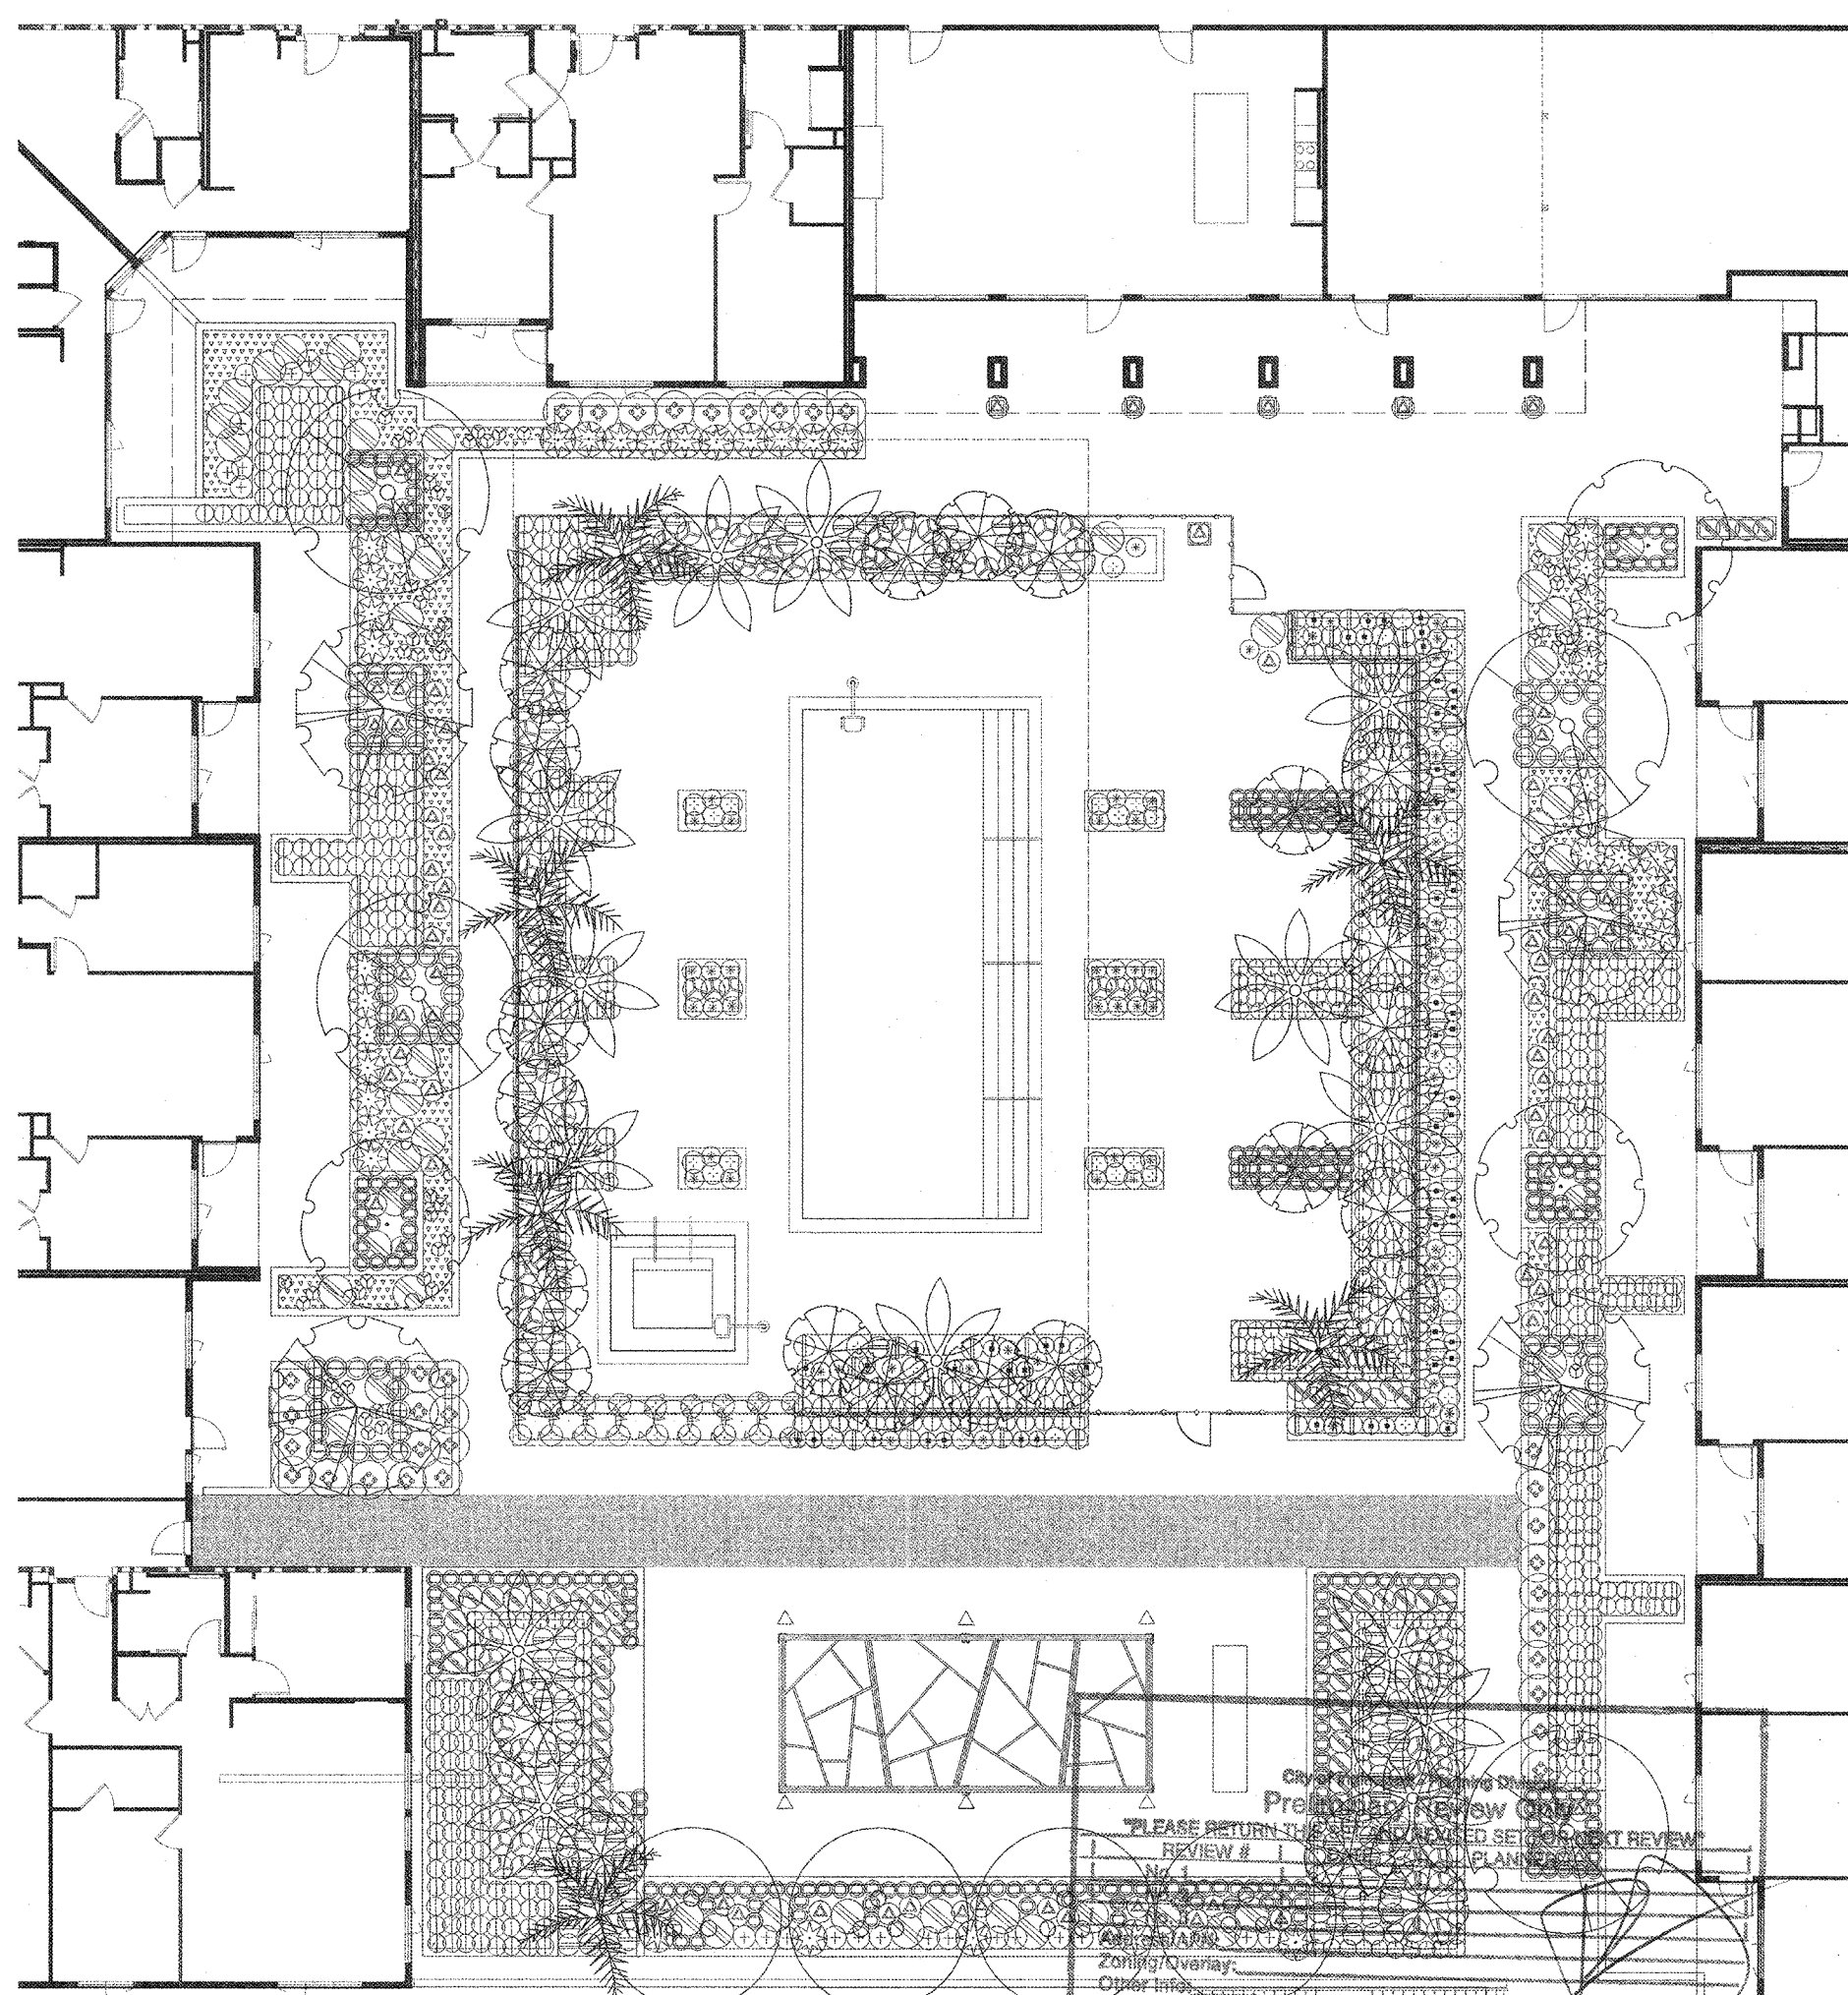

1 LANDSCAPE PLANTING PLAN LEVEL 02 (PODIUM) POOL COURTYARD  
SCALE: 1/8" = 1'-0"

NOT FOR CONSTRUCTION

TREE LEGEND:

SYMBOL	BOTANICAL NAME 'COMMON NAME'	SIZE	WUCOLS	COUNT
[Symbol]	<i>Archontophoenix cunninghamiana</i> King Palm	36"	M	23
[Symbol]	<i>Trachycarpus fortunei</i> Windmill Palm	36"	M	11
[Symbol]	<i>Streptocarpus</i> Giant Bird of Paradise	36"	M	34
[Symbol]	<i>Cercidium deserti</i> Museum Desert Museum Palo Verde	36"	VL	13
[Symbol]	<i>Chilopsis linearis</i> Desert Willow	36"	VL	4
[Symbol]	<i>Arbutus unedo</i> Strawberry Tree	36"	L	3
[Symbol]	<i>Agave attenuata</i> Proserpinqua Willow Tree	36"	L	4
[Symbol]	<i>Alnus rhombifolia</i> White Alder	36"	L	4
[Symbol]	<i>Tipuana tipu</i> Tipu Tree	36"	L	14
[Symbol]	<i>Pyrus calleryana 'chanticleer'</i> Chanticleer Pear	36"	M	4
[Symbol]	<i>Salix goodingii</i> Gooding's Black Willow	36"	H	6
[Symbol]	<i>Olea europaea 'Majestic Beauty'</i> Olive Tree	36"	L	1

SHRUB, VINE, AND GROUND COVER LEGEND:

SYMBOL	BOTANICAL NAME 'COMMON NAME'	SIZE	WUCOLS	SPACING
[Symbol]	<i>Zamia furfuracea</i> Cardboard Palm	5 GAL	M	SEE PLAN
[Symbol]	<i>Ficus pumila</i> Creeping Fig	5 GAL	M	SEE PLAN
[Symbol]	<i>Bauer's Draecena Palm</i> Cordylina 'Bauer'	5 GAL	M	SEE PLAN
[Symbol]	<i>Echeveria 'Afterglow'</i> Afterglow Echeveria	5 GAL	L	SEE PLAN
[Symbol]	<i>Phormium tenax 'Variegatum'</i> Green-Yellow New Zealand Flax	5 GAL	L	SEE PLAN
[Symbol]	<i>Woodwardia fimbriata</i> Giant Chain Fern	5 GAL	M	SEE PLAN
[Symbol]	<i>Philodendron 'Xanadu'</i> Philodendron Xanadu	5 GAL	L	SEE PLAN
[Symbol]	<i>Asplenium nidus</i> Bird's Nest Fern	5 GAL	M	SEE PLAN
[Symbol]	<i>Cissus antarctica</i> Kangaroo Vine	5 GAL	M	SEE PLAN
[Symbol]	<i>Asparagus densiflorus 'Myers'</i> Foxtail Fern	5 GAL	M	SEE PLAN
[Symbol]	<i>Agave 'Blue Flame'</i> Blue Flame Agave	5 GAL	L	SEE PLAN
[Symbol]	<i>Agave attenuata</i> Foxtail Agave	5 GAL	L	SEE PLAN
[Symbol]	<i>Aeonium 'Mint Sauce'</i> Green Aeonium	5 GAL	L	SEE PLAN
[Symbol]	<i>Agave dasymetana 'Variegata'</i> Variegated Dwarf Agave	5 GAL	L	SEE PLAN
[Symbol]	<i>Agave 'Blue Glow'</i> Blue Glow Agave	5 GAL	L	SEE PLAN
[Symbol]	<i>Senecio latifolius</i> Blue Finger	5 GAL	L	12" O.C.
[Symbol]	<i>Polystichum munifolium</i> Western Sword Fern	5 GAL	M	SEE PLAN
[Symbol]	<i>Dioscorea vitiensis</i> Fortnight Lily	5 GAL	L	12" O.C.
[Symbol]	<i>Euonymus japonicus 'Microphyllus Variegatus'</i> Variegated Boxleaf Euonymus	5 GAL	M	SEE PLAN
[Symbol]	<i>Rosmarinus officinalis 'Upright'</i> Upright Rosemary	5 GAL	L	SEE PLAN
[Symbol]	<i>Festuca ovina glauca</i> Blue Fescue	5 GAL	L	SEE PLAN
[Symbol]	<i>Agave parryi var. truncata</i> Parry's Agave	5 GAL	L	SEE PLAN
[Symbol]	<i>Agave victoriae-reginae</i> Queen Victoria Agave	5 GAL	L	SEE PLAN
[Symbol]	<i>Bougainvillea 'Mona'</i> Ocala Bougainvillea	5 GAL	L	SEE PLAN
[Symbol]	<i>Olea europaea 'Little Olive'</i> Little Olive	5 GAL	L	SEE PLAN
[Symbol]	<i>Aloe striata</i> Coral Aloe	5 GAL	L	SEE PLAN
[Symbol]	<i>Phormium 'Platts Black'</i> Black New Zealand Flax	5 GAL	M	SEE PLAN
[Symbol]	<i>Nassella tenuissima</i> Mexican Feathergrass	5 GAL	L	SEE PLAN
[Symbol]	<i>Senecio vitellus</i> Narrow-leaf Chalkedick	5 GAL	L	SEE PLAN
[Symbol]	<i>Lavandula angustifolia 'Hidcote Blue'</i> Hidcote Blue Lavender	5 GAL	L	SEE PLAN
[Symbol]	<i>Myrica communis</i> Dwarf Myrtle	1 GAL	L	9" O.C.
[Symbol]	<i>Dichondra argentea 'Silver Falls'</i> Silver Falls Dichondra	1 GAL	L	SEE PLAN
[Symbol]	<i>Senecio rowleyanus</i> String of Pearls	1 GAL	L	SEE PLAN
[Symbol]	<i>Leymnium condenseolus 'Canyon Prince'</i> Native Rye	5 GAL	L	36" O.C.
[Symbol]	<i>Juncus patens 'Elk Blue'</i> Elk Blue California Gray Rush	5 GAL	L	18" O.C.
[Symbol]	<i>Muhlenbergia capillaris</i> Gulf Muhly Grass	5 GAL	M	24" O.C.
[Symbol]	<i>Muhlenbergia rigens</i> Deer Grass	5 GAL	L	24" O.C.
[Symbol]	<i>Pennisetum alopecuroides</i> Dwarf Fountain Grass	5 GAL	M	12" O.C.
[Symbol]	<i>Trachypogon jamaicensis</i> Star Jasmine	5 GAL	M	SEE PLAN
[Symbol]	<i>Westringia 'Grey Box'</i> Dwarf Coast Rosemary	5 GAL	L	SEE PLAN
[Symbol]	<i>Euonymus fortunei 'Emerald Gaiety'</i> White Variegated Winter Creeper	5 GAL	M	SEE PLAN
[Symbol]	<i>Dioscorea bicolor</i> Fortnight Lily	5 GAL	L	SEE PLAN
[Symbol]	<i>Iris douglasiana</i> Douglas Iris	5 GAL	L	SEE PLAN
[Symbol]	<i>Dianella tasmanica 'Variegata'</i> Variegated Flax Lily	5 GAL	M	SEE PLAN
[Symbol]	<i>Pittosporum cressifolium 'Compact'</i> Dwarf Kari	5 GAL	M	SEE PLAN
[Symbol]	<i>Ligustrum japonicum</i> Japanese Privet	5 GAL	M	SEE PLAN
[Symbol]	<i>Gardenia jasminoides 'White Gem'</i> White Gem Gardenia	5 GAL	M	SEE PLAN
[Symbol]	<i>Myoporum parvifolium 'Prostratum'</i> Myoporum	5 GAL	L	SEE PLAN
[Symbol]	<i>Prunus caroliniana</i> Carolina Cherry Laurel, Column	5 GAL	M	SEE PLAN
[Symbol]	<i>Euonymus fortunei 'Colorata'</i> Purpleleaf Winter Creeper	5 GAL	M	SEE PLAN
[Symbol]	<i>Rhapidochloa indica</i> Indian Hawthorne	5 GAL	L	SEE PLAN
[Symbol]	<i>Carex macrocarpa 'Tulle'</i> Dwarf Nuts Plant	5 GAL	L	SEE PLAN
[Symbol]	<i>Dianella revoluta</i> Little Rev Flax Lily	5 GAL	L	SEE PLAN
[Symbol]	<i>Carex pansa</i> California Meadow Sedge	5 GAL	M	SEE PLAN
[Symbol]	<i>Baccharis 'Twin Peaks'</i> Coyote Brush	5 GAL	L	SEE PLAN
[Symbol]	<i>Sedum 'Cape Blanco'</i> Cape Blanco Stonecrop	5 GAL	L	SEE PLAN
[Symbol]	<i>Ribes 'Spooners Mesa'</i> Evergreen Currant	5 GAL	VL	SEE PLAN
[Symbol]	<i>Satureia douglasii</i> Yerba Buena	5 GAL	M	SEE PLAN
[Symbol]	<i>Casearia 'Cousin It'</i> Prostrate Swamp Oak	5 GAL	L	SEE PLAN
[Symbol]	<i>Pittosporum 'Golf Ball'</i> Golf Ball Kohuhu	5 GAL	M	SEE PLAN
[Symbol]	<i>Rosmarinus 'Gold Dust'</i> Gold Dust Rosemary	5 GAL	L	SEE PLAN
[Symbol]	<i>Salvia 'Santa Barbara'</i> Santa Barbara Sage	5 GAL	L	SEE PLAN
[Symbol]	<i>Sollya heterophylla</i> Australian Bluebell Creeper	5 GAL	L	SEE PLAN
[Symbol]	<i>Agapanthus africanus</i> Lily of the Nile	5 GAL	M	SEE PLAN
[Symbol]	<i>Carex divisa</i> Berkeley Sedge	5 GAL	L	SEE PLAN
[Symbol]	<i>Rosa alba 'White Rose of York'</i> White Rose	5 GAL	M	SEE PLAN
[Symbol]	<i>Nerium oleander</i> Oleander	5 GAL	L	SEE PLAN
[Symbol]	<i>Pittosporum tenuifolium 'Silver Sheen'</i> Silver Sheen Kohuhu	5 GAL	M	SEE PLAN

**TCA ARCHITECTS**  
LOS ANGELES | IRVINE | OAKLAND  
THESE DOCUMENTS ARE THE PROPERTY OF TCA ARCHITECTS, INC. NO PART OF THESE DOCUMENTS MAY BE REPRODUCED OR TRANSMITTED IN ANY FORM OR BY ANY MEANS, ELECTRONIC OR MECHANICAL, WITHOUT THE WRITTEN PERMISSION OF TCA ARCHITECTS, INC.

**WILSON MEANY**  
ARCHITECTS  
1200 WEST 10TH AVENUE, SUITE 200  
DENVER, COLORADO 80202  
303.733.1100  
WWW.WILSONMEANY.COM

**LANDSCAPE ARCHITECT**  
REGISTERED PROFESSIONAL  
STATE OF CALIFORNIA  
120217  
110217

**HOLLYWOOD PARK RESIDENTIAL - MU-10**  
INGLEWOOD, CALIFORNIA  
**HOLLYWOOD PARK RETAIL AND COMMERCIAL INVESTORS, LLC**

**LANDSCAPE ENLARGEMENT PLAN LEVEL 02 (PODIUM)**  
**NOT FOR CONSTRUCTION**

THIS SET OF CONSTRUCTION DOCUMENTS HAS BEEN PREPARED FOR THE CONSTRUCTION OF AN APARTMENT PROJECT.

**LP3.03**  
2017-08-01  
JOB NUMBER  
SCALE  
PLOT PLAN RESUBMITTAL  
DATE  
06-21-2018  
DATE DATE

**811** Know what's below. Call before you dig.