

MATERIAL KEYNOTES

- 1 EXTERIOR STUCCO WALL - 20 / 30 SAND FINISH
- 2 STO EXTERIOR PLASTER - LIMESTONE FINISH
- 3 LIMESTONE - LIMOUX VENEER - COMBED FINISH
- 4 METAL FASCIA PANEL - POWDER COAT
- 5 ALUMINUM CANOPY - POWDER COAT
- 6 NOT USED
- 7 METAL SCREEN WALL - POWDER COAT
- 8 ALUMINUM SHADE STRUCTURE - POWDER COAT
- 9 METAL & GLASS GATE w/ FIXED SIDE LIGHT
- 10 VINYL WINDOWS - COLOR TBD
- 11 ALUMINUM STOREFRONT WINDOWS - ANNOZED ALUMINUM
- 12 HORIZONTAL METAL GUARD RAIL - PAINT
- 13 CEMENT FIBER BOARD SIDING - ARTISAN V-RUSTIC
- 14 ALUMINUM GUTTER - POWDER COAT

NOTES

- 1. ALL ILLUMINATION WILL BE CONFINED TO THE SITE AND WILL NOT CAUSE ANY GLARE TO ADJACENT PROPERTIES.
- 2. ALL SIGNAGE WILL BE UNDER A SEPARATE PERMIT.
- 3. INTERIOR NOISE LEVELS ATTRIBUTABLE TO EXTERIOR NOISE WILL NOT EXCEED 45 DECIBELS IN ANY HABITABLE ROOM.
- 4. SEE SHEET AS.20 FOR WINDOW SCHEDULE, AND ACOUSTICAL REQUIREMENT.



WILSON MEANY


HOLLYWOOD PARK RESIDENTIAL - MU-10
INGLEWOOD, CALIFORNIA
HOLLYWOOD PARK RETAIL AND COMMERCIAL INVESTORS, LLC

EXTERIOR ELEVATIONS

NOT FOR CONSTRUCTION

City of Inglewood - Planning Division
Preliminary Review Only
PLEASE RETURN THIS SET AND REVISED SET FOR NEXT REVIEW
REVIEW # _____ DATE _____ PLANNER _____
No. 1 _____
No. 2 _____
No. 3 _____
Address/AFN: _____
Zoning/Overlay: _____
City/County: _____
Please note that this plan has been reviewed based on the information provided by you, the applicant. A more in-depth review may result in a need for additional information or changes to your plan. This stamp acknowledges that we have reviewed your plan and we find that it complies with applicable codes and regulations. If there are any "NOT" items noted by the Planning Division and will require further review, see Specific Comments on plan (in red).

KEY PLAN

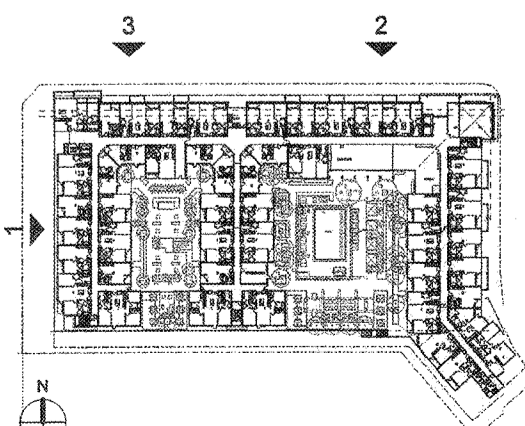

THIS SET OF CONSTRUCTION DOCUMENTS HAS BEEN PREPARED FOR THE CONSTRUCTION OF AN APARTMENT PROJECT
A2.10
2017-083-02
JOB NUMBER
As Indicated
SHEET
PLOT PLAN RESUBMITTAL
08/21/2018
ISSUE DATE



1 WEST ELEVATION
1/8" = 1'-0"



2 NORTH ELEVATION - A
1/8" = 1'-0"



3 NORTH ELEVATION - B
1/8" = 1'-0"

