

EASEMENT NOTES:

- 15' WIDE EXISTING STORM DRAIN EASEMENT LINE WAS RELOCATED AND REMOVED. EASEMENT TO BE QUIT CLAIMED.
- 40' WIDE PROPOSED EASEMENT FOR ACCESS AND UTILITY PURPOSES.
- VARIES WITH PROPOSED EASEMENT FOR ACCESS AND UTILITY PURPOSES.

TA
ARCHITECTS
LOS ANGELES | IRVINE | CARLSBAD

WILSON MEANY

D & D ENGINEERING, INC.

DATE	
DESCRIPTION	
REVISION	

HOLLYWOOD PARK RESIDENTIAL - MU-2C
INGLEWOOD, CALIFORNIA
HOLLYWOOD PARK RETAIL AND COMMERCIAL INVESTORS, LLC


EXISTING CONDITIONS
NOT FOR CONSTRUCTION

City of Inglewood - Planning Division
Preliminary Review Only
"PLEASE RETURN THIS SET AND REVISED SET FOR NEXT REVIEW"

REVISION	DATE	PLANNER
No. 1		
No. 2		
No. 3		

Address/APN: _____
Zoning/Overlay: _____
Other Info: _____

Please note that this plan has been approved based on the information provided by you, the applicant. A more in-depth review may be required for additional information or changes to your plan. The stamp acknowledges that we have reviewed your plan and we find that it requires additional information for corrections. These plans have NOT been approved by the Planning Division and will require further review. See Specific Comments on plans (if any).

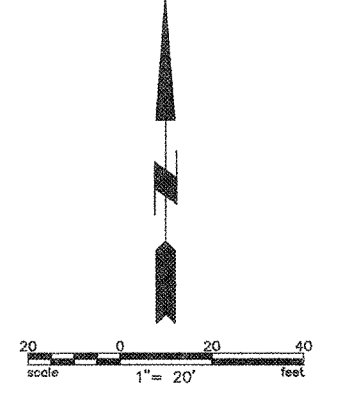

THIS SET OF CONSTRUCTION DOCUMENTS HAS BEEN PREPARED FOR THE CONSTRUCTION OF AN AGREEMENT PROJECT.

C1.01
2017-083-01
JOB NUMBER
1" = 20'
SCALE
PLOT PLAN RESUBMITTAL
DATE: 06-21-2018
ISSUE DATE