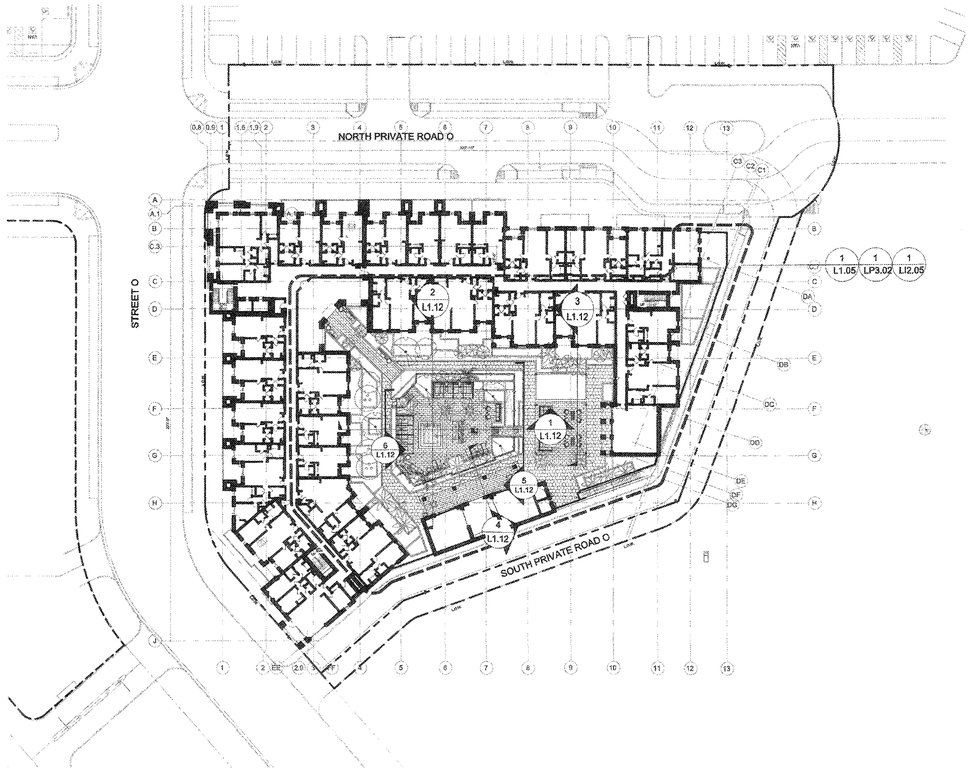

2 CONSTRUCTION OVERALL PLAN_LEVEL 03 (PODIUM)
SCALE: 1/32" = 1'-0"

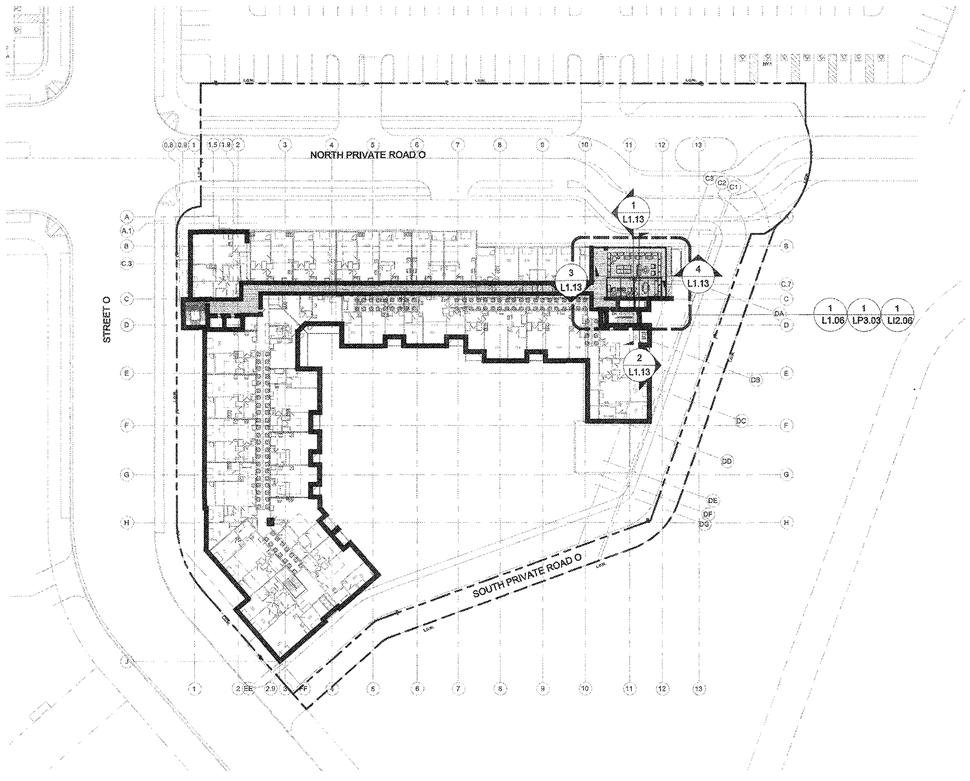

3 CONSTRUCTION OVERALL PLAN_LEVEL 06 (ROOF)
SCALE: 1/32" = 1'-0"

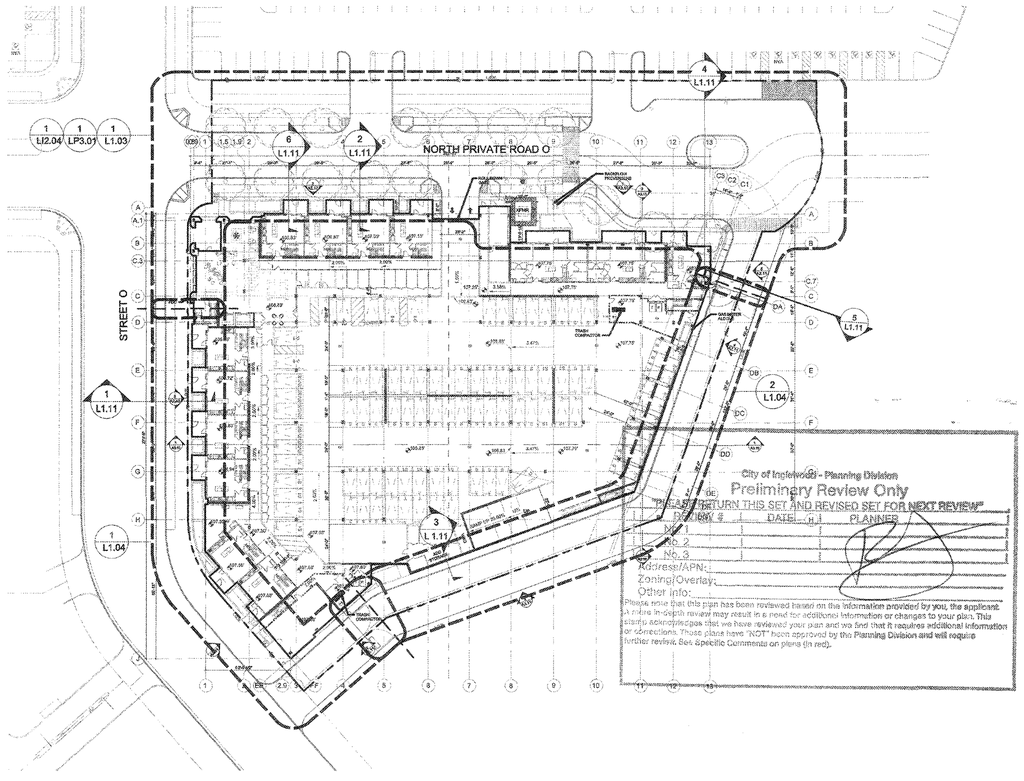

1 CONSTRUCTION OVERALL PLAN_LEVEL 01 (STREET)
SCALE: 1/32" = 1'-0"

TCA ARCHITECTS
LOS ANGELES | IRVINE | OAKLAND

This document is the property of TCA Architects, Inc. ©2018 Any use of this document without TCA authorization is strictly forbidden.

WILSON MEANY

HONG.JOO KIM LANDSCAPE ARCHITECTS
710 N. Olympic Blvd., #10-115, Los Angeles, CA 90015
310.389.3474 | info@HKLARC.COM

DATE	REVISIONS

HOLLYWOOD PARK RESIDENTIAL - MU-2C
INGLEWOOD, CALIFORNIA
HOLLYWOOD PARK RETAIL AND COMMERCIAL INVESTORS, LLC

DRAWING CONTENTS
LANDSCAPE OVERALL PLANS

NOT FOR CONSTRUCTION

THIS SET OF CONSTRUCTION DOCUMENTS HAS BEEN PREPARED FOR THE CONSTRUCTION OF AN APARTMENT PROJECT.

L1.01
2017-083
JOB NUMBER

SCALE
PLOT PLAN RESUBMITTAL
ISSUED AS
06-21-2018
ISSUE DATE