TREE LEGEND:

SYMBOL	BOTANICAL NAME "COMMON NAME"	SIZE	WUCOLS
	Carcioium Desert Museum Desert Museum Palo Verde	36"	VL
	Arbutus unedo Strawberry Tree	36"	L
	Archontophoenix cunninghamiana King Palm	36"	M
	Chilopsis linearis Desert Willow	36"	VL
	Trachycarpus fortunei Windmill Palm	36"	M
	Strelitzia nicholai Giant Bird of Paradise	36"	M
	Tipuana Tipu Tipu tree	36"	M

SHRUB, VINE, AND GROUNDCOVER LEGEND:

SYMBOL	BOTANICAL NAME "COMMON NAME"	SIZE	WUCOLS	SPACING
	Zamia furfuracea Cardboard Palm	5 GAL	M	SEE PLAN
	Ficus pumila Creeping Fig	5 GAL	M	SEE PLAN
	Bauer's Dracaena Palm Cordyline 'Bauer'	5 GAL	M	SEE PLAN
	Echeveria 'Afterglow' Afterglow Echeveria	5 GAL	L	SEE PLAN
	Phormium tenax 'Variegatum' Green-Yellow New Zealand Flax	5 GAL	L	SEE PLAN
	Woodwardia fimbriata Giant Chain Fern	5 GAL	M	SEE PLAN
	Philodendron 'Xanadu' Philodendron Xanadu	5 GAL	L	SEE PLAN
	Asplenium nidus Bird's Nest Fern	5 GAL	M	SEE PLAN
	Cissus antartica Kangaroo Vine	5 GAL	M	SEE PLAN
	Asparagus densiflorus 'Myers' Foxtail Fern	5 GAL	M	SEE PLAN
	Agave 'Blue Flame' Blue Flame Agave	5 GAL	L	SEE PLAN
	Agave attenuata Dwarf Myrtle	5 GAL	L	SEE PLAN
	Aeonium 'Mint Saucer' Green Aeonium	5 GAL	L	SEE PLAN
	Agave desmettiana 'Variegata' Variegated Dwarf Agave	5 GAL	L	SEE PLAN
	Agave 'Blue Glow' Blue Glow Agave	5 GAL	L	SEE PLAN
	Senecio talinoides Blue Finger	5 GAL	L	12" O.C.
	Polystichum munitum Western Sword Fern	5 GAL	M	SEE PLAN
	Dietes iridioides Fortnight Lily	5 GAL	L	12" O.C.
	Euonymus japonicus 'Microphyllus Variegatus' Variegated Boxleaf Euonymus	5 GAL	M	SEE PLAN
	Rosmarinus officinalis 'Upright' Upright Rosemary	5 GAL	L	SEE PLAN
A	*Festuce ovina glauca* Blue Fescue	5 GAL	L	SEE PLAN
	Agave parryi var. truncata Parry's Agave	5 GAL	L	SEE PLAN
	Agave victoriae-reginae Queen Victoria Agave	5 GAL	L	SEE PLAN
	Bougainvillea 'Monka' Oo-La-La Bougainvillea	5 GAL	L	SEE PLAN
B	*Olea europeea 'Little Ollie'* Little Ollie	5 GAL	L	SEE PLAN
	Aloe striata Coral Aloe	5 GAL	L	SEE PLAN
C	*Phormium 'Platts Black'* Black New Zealand Flax	5 GAL	M	SEE PLAN
	Nassella Tenuissima Mexican Feathergrass	5 GAL	L	SEE PLAN
	Senecio vitalis Narrow-leaf Chalksticks	5 GAL	L	SEE PLAN
	Lavandula angustifolia 'Hidcote Blue' Hidcote Blue Lavender	5 GAL	L	SEE PLAN
	Myrtus communis Dwarf Myrtle	1 GAL	L	9" O.C.
	Dichondra argentea 'Silver Falls' Silver Falls Dichondra	1 GAL	L	SEE PLAN
	Senecio rowleyanus String of Pearls	1 GAL	L	SEE PLAN
	Leymus condensatus 'Canyon Prince' Native Blue Rye	5 GAL	L	36" O.C.
	Juncus patens 'Elk Blue' Elk Blue California Gray Rush	5 GAL	L	18" O.C.
	Muhlenbergia capillaris Gulf muhly Grass	5 GAL	M	24" O.C.
	Muhlenbergia rigens Deer Grass	5 GAL	L	24" O.C.
	Pennisetum alopecuroides Dwarf Fountain Grass	5 GAL	M	12" O.C.
	Trachelospermum jasminoides Star Jasmine	5 GAL	M	SEE PLAN
D	*Westringia 'Grey Box'* Dwarf Coast Rosemary	5 GAL	L	SEE PLAN
E	*Euonymus fortunei 'Emerald Gaiety'* White Variegated Winter Creeper	5 GAL	M	SEE PLAN
F	*Dietes bicolor* Fortnight Lily	5 GAL	L	SEE PLAN
G	*Iris douglasiana* Douglas Iris	5 GAL	L	SEE PLAN
H	*Dianella tasmanica 'Variegata'* Variegated Flax Lily	5 GAL	M	SEE PLAN
I	*Pittosporum crassifolium 'Compacta'* Dwarf Karo	5 GAL	M	SEE PLAN
J	*Ligustrum japonicum* Japanese Privet	5 GAL	M	SEE PLAN
K	*Gardenia jasminoides 'White Gem'* White Gem Gardenia	5 GAL	M	SEE PLAN
L	*Myoporum parvifolium 'Prostratum'* Myoporum	5 GAL	L	SEE PLAN
M	*Prunus carolliniana* Carolina Cherry Laurel, Column	5 GAL	M	SEE PLAN
N	*Euonymus fortunei 'Colorata'* Purpleleaf Winter Creeper	5 GAL	M	SEE PLAN
O	*Rhapidiepsis indica* Indian Hawthorne	5 GAL	L	SEE PLAN
P	*Cariesa macrocarpa 'Tuttle'* Dwarf Natal Plum	5 GAL	L	SEE PLAN
Q	*Dianella revoluta* Little Rev Flax Lily	5 GAL	L	SEE PLAN
R	*Carex pansa* California Meadow Sedge	5 GAL	M	SEE PLAN
S	*Baccharis 'Twin Peaks'* Coyote Brush	5 GAL	L	SEE PLAN
T	*Sedum 'Cape Blanco'* Cape Blanco Stonecrop	5 GAL	L	SEE PLAN
U	*Ribes 'Spooner's Mesa'* Evergreen Currant	5 GAL	VL	SEE PLAN
V	*Satureja douglasii* Yerba Buena	5 GAL	M	SEE PLAN
W	*Casuarina 'Cousin It'* Prostrate Swamp Oak	5 GAL	L	SEE PLAN
X	*Pittosporum 'Golf Ball'* Golf Ball Kohuhu	5 GAL	M	SEE PLAN
Y	*Rosmarinus 'Gold Dust'* Gold Dust Rosemary	5 GAL	L	SEE PLAN
Z	*Salvia 'Santa Barbara'* Santa Barbara Sage	5 GAL	L	SEE PLAN
	Sollya heterophylla Australian Bluebell Creeper	5 GAL	L	SEE PLAN
	Agapanthus africanus Lily of the Nile	5 GAL	M	SEE PLAN
	Carex divulsa Berkeley Sedge	5 GAL	L	SEE PLAN
	Rosa alba 'White Rose of York' White Rose	5 GAL	M	SEE PLAN
	Nerium oleander Oleander	5 GAL	L	SEE PLAN
	Pittosporum tenuifolium 'Silver Sheen' Silver Sheen Kohuhu	5 GAL	M	SEE PLAN

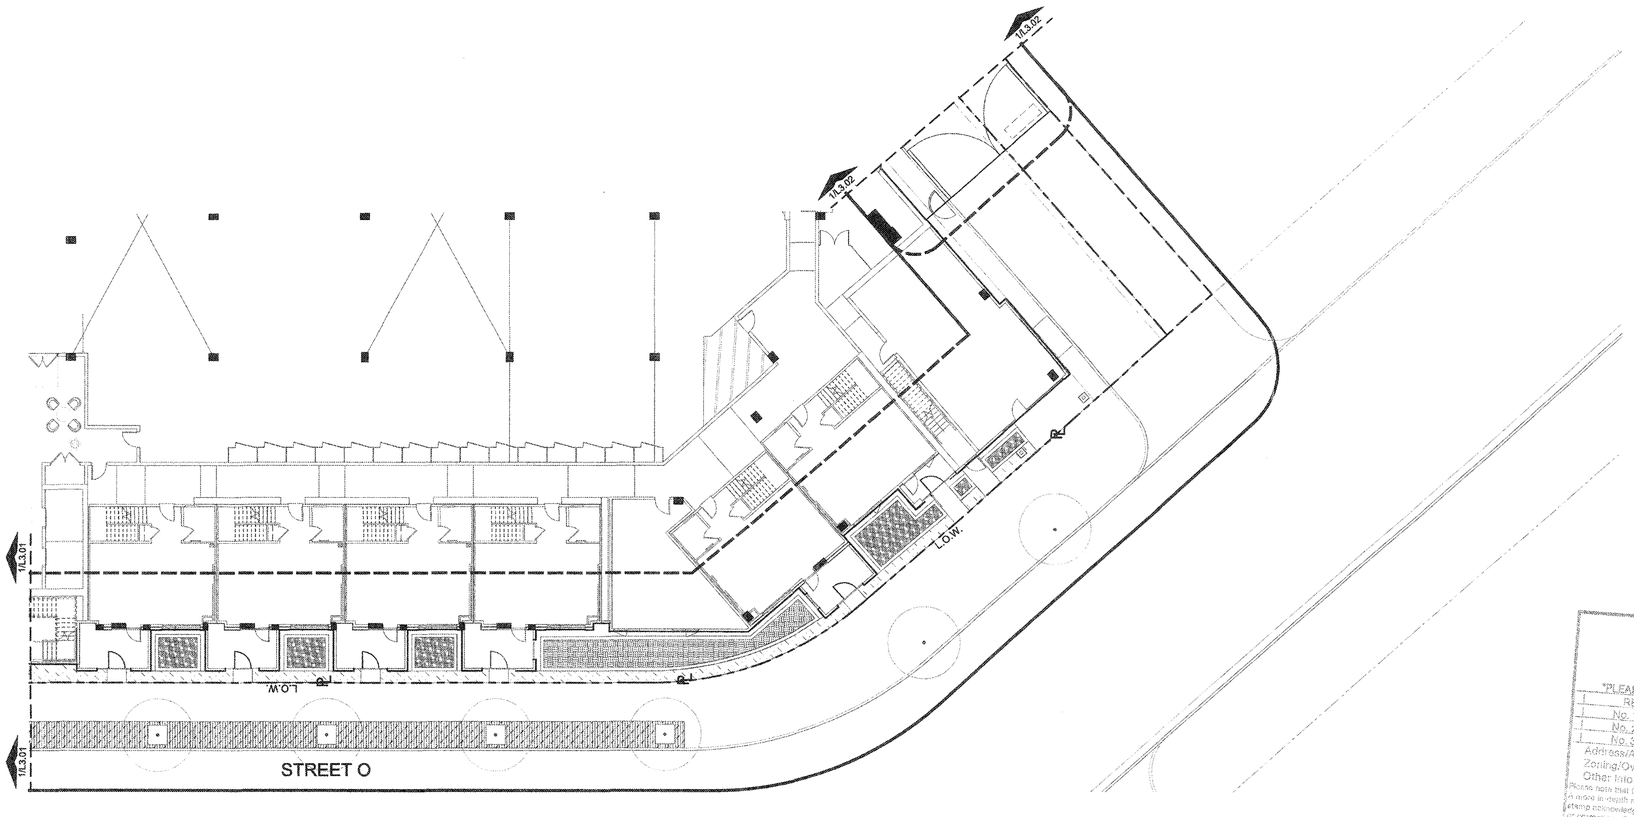

1 LANDSCAPE PLANTING PLAN_LEVEL 1 ENLARGEMENT
SCALE: 3/32" = 1'-0"

NORTH

City of Inglewood - Planning Division
Preliminary Review Only
"PLEASE RETURN THIS SET AND REVISED SET FOR NEXT REVIEW"

REVIEW #	DATE	PLANNER
No. 1		
No. 2		
No. 3		

Address/APN:
Zoning/Overlay:
Other Info:

Please note that this plan has been reviewed based on the information provided by you, the applicant. An initial in-depth review may result in a need for additional information or changes to your plan. This attempt acknowledges that we have reviewed your plans and we find that it requires additional information or corrections. Please place a "NOT" been approved by the Planning Division and will require further review. See Specific Comments on plans (if any).

TCA ARCHITECTS
LOS ANGELES | IRVINE | OAKLAND

Title 17 Section 4 is the property of TCA Architects, Inc. ©2018 Any use of this document without TCA authorization is strictly forbidden.

WILSON MEANY

HONGJOO KIM LANDSCAPE ARCHITECTS
701 W. Olympic Blvd., #1B 195, Los Angeles, CA 90015
(213) 622-3434 t. HKLA@HotMail.COM

REGISTERED LANDSCAPE ARCHITECT HONGJOO KIM NO. 5491 RENEWAL 12/31/17 12/31/19 STATE OF CALIFORNIA

NO./MARK	REVISION	DATE

HOLLYWOOD PARK RESIDENTIAL - MU-2C
INGLEWOOD, CALIFORNIA
HOLLYWOOD PARK RETAIL AND COMMERCIAL INVESTORS, LLC

DRAWING CONTENTS
LANDSCAPE PLANTING PLAN_LEVEL 1 ENLARGEMENT

NOT FOR CONSTRUCTION

THIS SET OF CONSTRUCTION DOCUMENTS HAS BEEN PREPARED FOR THE CONSTRUCTION OF AN APARTMENT PROJECT.

LP3.03

2017-033
JOB NUMBER

SCALE
PLOT PLAN RESUBMITTAL
SET OR ADDENDUM

06-21-2018
ISSUE DATE