LAVANDULA ANGUSTIFOLIA 'HIDCOTE BLUE'
HIDCOTE BLUE LAVENDER

PENNISETUM ALOPECUROIDES
DWARF FOUNTAIN GRASS

IRIS DOUGLASIANA
DOUGLAS IRIS

CAREX PANSA
CALIFORNIA MEADOW SEDGE

BIORE-TENTION PLANTS

CAREX DIVULSA
BERKELEY SEDGE

MUHLENBERGIA RIGENS
DEER GRASS

MUHLENBERGIA CAPILLARIS
GULF MUHLY GRASS

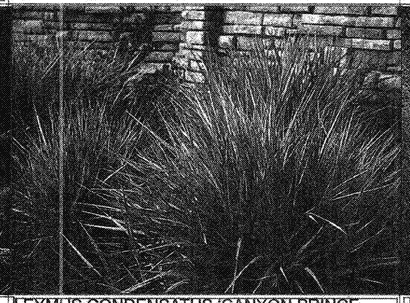

LEYMUS CONDENSATUS 'CANYON PRINCE
NATIVE BLUE RYE

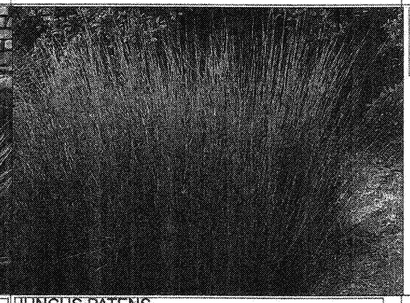

JUNCUS PATENS
CALIFORNIA GRAY RUSH

City of Inglewood - Planning Division
Preliminary Review Only
"PLEASE RETURN THIS SET AND REVISED SET FOR NEXT REVIEW"

REVIEW #	DATE	PLANNER
No. 1		
No. 2		
No. 3		

Address/APN:
Zoning/Overlay:
Other Info:

Please note that this plan has been reviewed based on the information provided by you, the applicant. A more in-depth review may result in a need for additional information or changes to your plan. This stamp acknowledges that we have reviewed your plan and we find that it requires additional information or corrections. These plans have "NOT" been approved by the Planning Division and will require further review. See Specific Comments on plans (in red).

TCA ARCHITECTS
LOS ANGELES | IRVINE | OAKLAND

This document is the property of TCA Architects, Inc. ©2018 Any use of this document without TCA authorization is strictly forbidden.

WILSON MEANY

HONGJOO KIM LANDSCAPE ARCHITECTS
719 W. Olympic Blvd., Ste 705, Los Angeles, CA 90036
213.283.5434 | HKLA@HKLANDCOM

LICENSED LANDSCAPE ARCHITECT HONGJOO KIM NO. 5417 Expires 12/31/17 Licensed Date 11/28/17 STATE OF CALIFORNIA

REVISION	REMARKS	DATE

HOLLYWOOD PARK RESIDENTIAL - MU-2C
INGLEWOOD, CALIFORNIA
HOLLYWOOD PARK RETAIL AND COMMERCIAL INVESTORS, LLC

DRAWINGS CONTENTS
LANDSCAPE PLANTING IMAGES

NOT FOR CONSTRUCTION

THIS SET OF CONSTRUCTION DOCUMENTS HAS BEEN PREPARED FOR THE CONSTRUCTION OF AN APARTMENT PROJECT.

LP3.15

2017-083
JOB NUMBER

SCALE
PLOT PLAN RESUBMITTAL
ISSUED AS
06-21-2018
ISSUE DATE