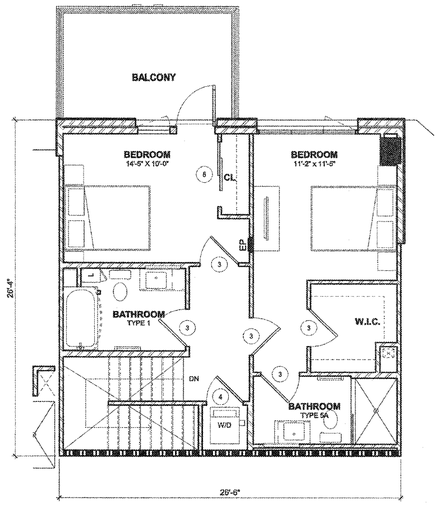

2 UNIT-TH2-SECOND FLOOR
1/4" = 1'-0"

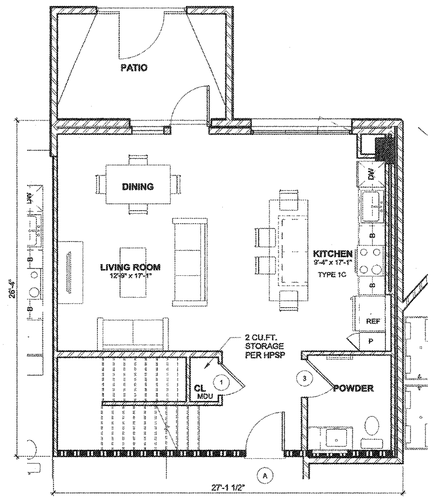

1 UNIT-TH2-FIRST FLOOR
1/4" = 1'-0"

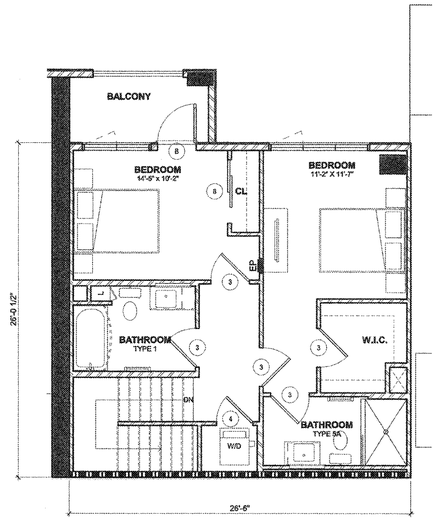

4 UNIT-TH3-SECOND FLOOR
1/4" = 1'-0"

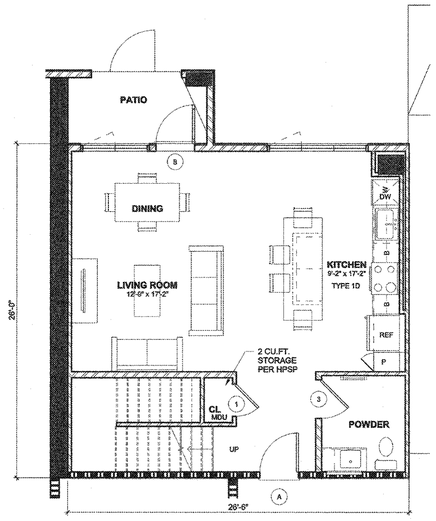

3 UNIT-TH3-FIRST FLOOR
1/4" = 1'-0"

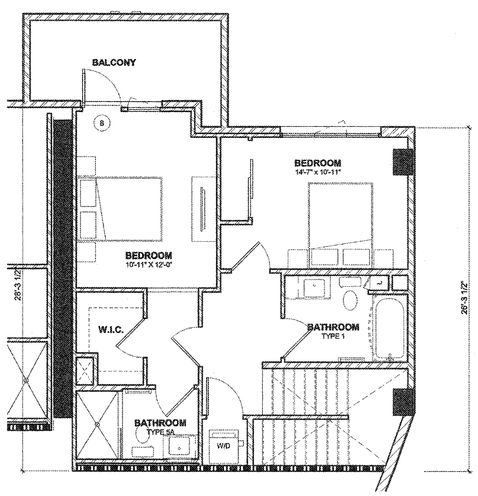

6 UNIT-TH4-SECOND FLOOR
1/4" = 1'-0"

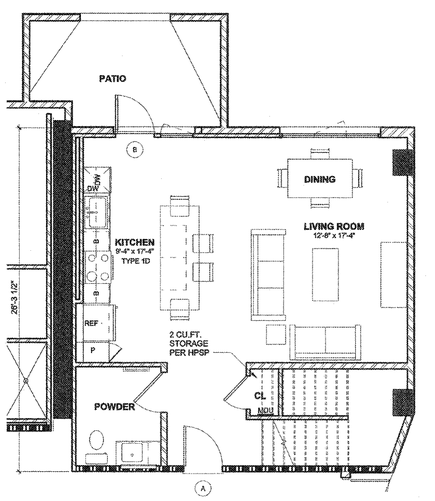

5 UNIT-TH4-FIRST FLOOR
1/4" = 1'-0"

NOTES

1. INTERIOR NOISE LEVELS ATTRIBUTABLE TO EXTERIOR NOISE WILL NOT EXCEED 45 DECIBELS IN ANY HABITABLE ROOM.

City of Inglewood - Planning Division
Preliminary Review Only
"PLEASE RETURN THIS SET AND REVISED SET FOR NEXT REVIEW"

REVIEW #	DATE	PLANNER
No. 1		
No. 2		
No. 3		

Address/APN:
Zoning/Overlay:
Other Info:
Please note that this plan has been reviewed based on the information provided by you, the applicant. A more in-depth review may result in a need for additional information or changes to your plan. This stamp acknowledges that we have reviewed your plan and we find that it requires additional information for further review. See Specific Comments on plans (in red).

TCA ARCHITECTS
LOS ANGELES | IRVINE | OAKLAND
This document is the property of TCA Architects, Inc. ©2016 Any use of this document without TCA authorization is strictly prohibited.

REVISION | DESCRIPTION | DATE

HOLLYWOOD PARK RESIDENTIAL - MU-2C
INGLEWOOD, CALIFORNIA
HOLLYWOOD PARK RETAIL AND COMMERCIAL INVESTORS, LLC

ENTITLEMENT SET
UNIT PLANS

NOT FOR CONSTRUCTION

THIS SET OF CONSTRUCTION DOCUMENTS HAS BEEN PREPARED FOR THE CONSTRUCTION OF AN APARTMENT PROJECT.

A4.03*

2017-083-01 JOB NUMBER
As indicated SCALE
PLOT PLAN RESUBMITTAL ISSUED AS
06/21/2018 ISSUE DATE