

CONSTRUCTION NOTES

NO.	DESCRIPTION OFF-SITE SIGNING AND STRIPING NOTES
1	INSTALL 12" WHITE STOP BAR MARKINGS
4	INSTALL TYPE IV LEFT ARROW LANE LINE CHANNELIZING LINE
6	INSTALL 4" WHITE PER DETAIL 8 LINE <i>Detail 8</i>
6	INSTALL 8" WHITE PER DETAIL 38 <i>38A</i>
10	INSTALL DETAIL 21 <i>ok</i>
11	INSTALL 8" WHITE PER DETAIL 38A <i>NOT SHOWN ON PLAN</i>
13	INSTALL 12" WHITE CROSSWALK STRIPING PER CA MUTCD & CALTRANS STD PLANS
18	INSTALL DETAIL 32 3 WHITE SOLID LINE
20	INSTALL 4" WHITE-LANE (TYR. 50')
21	GRIND EXISTING THERMOPLASTIC OR GOLD PLANE CONFLICTING STRIPING AND LEGENDS AS NEEDED. SLURRY SEAL ALL REMOVALS.
22	SIGNALIZED INTERSECTION

SIGN LEGEND


SIGN	DESCRIPTION
R2-1	SPEED LIMIT SIGN
R26(S)(CA)	NO STOPPING ANYTIME

+ Add Pictures

Same

ARE THESE NEW INSTALLATIONS? PLEASE VERIFY AERIAL IMAGE SHOWS IT TO BE DIFFERENT

AND/OR LIMIT LINE

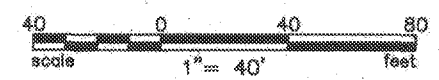


PRELIMINARY PLANS
NOT APPROVED FOR CONSTRUCTION

OWNER / DEVELOPER:
HOLLYWOOD PARK LAND CO., LLC
6100 CENTER DRIVE, SUITE 1020
LOS ANGELES, CA 90045
RE: HOLLYWOOD PARK, INGLEWOOD

DAVID EVANS AND ASSOCIATES INC.
145 S. SPRING STREET, SUITE 120
LOS ANGELES, CA 90012
Phone: 213.785.7887

PREPARED UNDER THE SUPERVISION OF:
Karl Mallick
KARL MALLICK, R.C.E. 42529
DATE: 10/01/2019

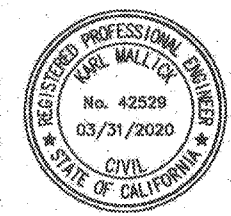

NO.	DATE	REVISION DESCRIPTION	REVISED BY	APPROVED BY	DATE

APPROVED BY: PUBLIC WORKS DIRECTOR
LOUIS A. ATWELL, R.C.E. 53062 DATE _____
SUBMITTED BY:
DAVID EVANS AND ASSOCIATES, INC.
CHECKED BY:
ATKINS NORTH AMERICA, INC.

CITY OF INGLEWOOD, CALIFORNIA
PUBLIC WORKS DEPARTMENT

TRAFFIC SIGNAL IMPROVEMENT PLANS
HOLLYWOOD PARK PROJECT
PIN CAY DRIVE
FROM STA 30+00.00 TO STREET 0-9

PERMIT NUMBER:	PLAN SCALE:	SHEET NO.	PLAN NO.
	AS NOTED	04 OF 4	SS-XXXX

Know what's below.
Call before you dig.

CALL 811
AT LEAST TWO DAYS BEFORE YOU DIG

UNDERGROUND SERVICE ALERT OF SOUTHERN CALIFORNIA

Drawing Name: M:\07119\Eng\07119-2016\07119-2016\Final Plans\Site\Site\Signing and Striping\CA_070119-2016.dwg
Last Opened: Oct 01, 2019 11:08am by: Alma

NS-SS